

Map No. Kans Sec. 5 Twp. 31 R. 6^E


Well No. 1 Eastman Farm
Shaver & Sutter Company

_____ Ft. from N. Line

200 Ft. from S. Line

200 Ft. from E. Line

_____ Ft. from W. Line

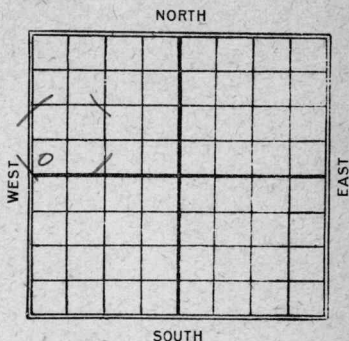

Date	REPORT
<u>1924</u>	
<u>11/26</u>	<u>Spudding</u>
<u>12/17</u>	<u>Dlg 1540'</u>
<u>1925</u>	
<u>1/21</u>	<u>Dlg 2460</u>
<u>3/30</u>	<u>Gas 2776-2800</u>
	<u>Oil 2844-52</u>
	<u>40 gts 40 Bbls</u>

Map No. ² **KANSAS** Sec. 5 Twp. 31 R. 6^E

Well No. 1 Eastman

Shaner & Sutter Company

Contractor

FIRST REPORT

_____ Ft. from N. Line

200 Ft. from S. Line

200 Ft. from E. Line

_____ Ft. from W. Line

SECTION PLAT

0			

Location _____

Rig up _____

Drilling and Remarks:

spudding

RECORD

Cased _____ in., _____ ft.

Sand _____

Gas _____

Oil _____

Total Depth _____

PRODUCTION

1st 24 hrs. Nat. _____

1st 24 hrs. after shot _____

Gas _____ Cu. Ft.

Dry Hole _____

Abandoned _____

Date **NOV 26 1924**

M. A. BENEAR

192

Scout

Map No. **2** **KANSAS** Sec. **5** Twp. **31** R. **6**

Well No. **1 Eastman**

shaver & sutter Company

Contractor

COMPLETED

SECTION PLAT

_____ Ft. from N. Line

200' Ft. from S. Line

_____ Ft. from E. Line

200' Ft. from W. Line

0			

Location _____

Rig up _____

Drilling and Remarks:

shot 40 gts.

RECORD

Cased _____ in., _____ ft.

Sand _____

Gas **2776-2800**

Oil **2844-52**

Total Depth **2852**

PRODUCTION

1st 24 hrs. Nat. _____

1st 24 hrs. after shot **40**

Gas _____ Cu. Ft.

Dry Hole _____

Abandoned _____

Date

3/30 19**25**

M. A. BENEAR

Scout