


Map No. **KANSAS** Sec. **30** Twp. **31** R. **6**

Well No. **1 - Pierce** Farm  
**Lewis Producing** Company

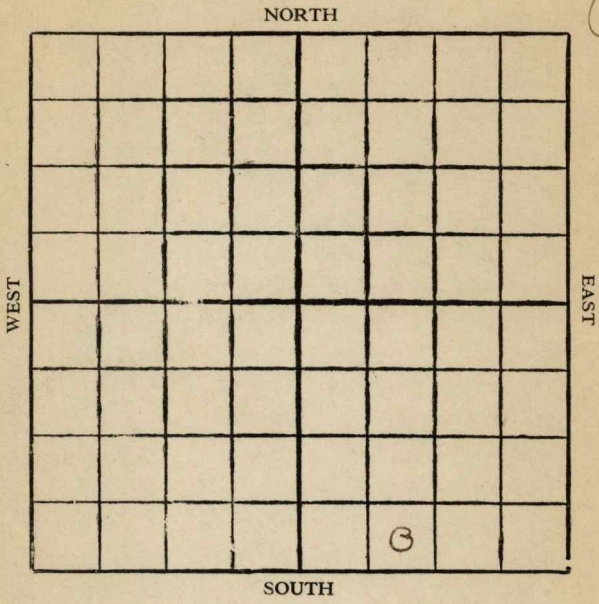

Location .....

Drilling Remarks

.....

.....

Rig Up .....

Drilling Remarks

.....

.....

**RECORD**

Cased ..... in. .... ft.

Sand .....

Gas .....

Oil .....

Total Depth .....

**PRODUCTION**

1st 24 hrs. Nat. ....

1st 24 hrs. after shot .....

Gas ..... cu. ft.

Dry Hole .....

Abandoned .....

Map No. **KANSAS** Sec. 30 Twp. 31 R. 6


Well No. 1 - Pierce Farm  
Lewis Producing Company

\_\_\_\_\_ Ft. from N. Line

330 Ft. from S. Line

\_\_\_\_\_ Ft. from E. Line

990 Ft. from W. Line

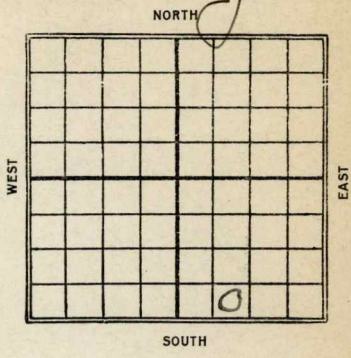

1928

Date	REPORT
2/15	Location
2/23	_____
3/1	Bldg rig
3/8	Rigging up -
3/16	Drlg - 720
3/22	" 1130
3/29	" 1795
4/5	Ady line 2270 - 2308 Show oil 2279 - drlg 2525
4/12	Top sand 2908 - 70 - T.D. 2979 Swab 2 1/2 bbls 9 hrs - shot 80 qts
	Cleaning out -
4/19	2908 - 2970 T.D. 2979 80/25 bbls oil
	5 .. water

*Cowley*

Map No. 2 **KANSAS** Sec. 30 Twp. 31 R. 6

Well No. 1 *Fierce*

*Lewis Producing Co* Company

Contractor

**FIRST REPORTS.**

**SECTION PLAT**

----- Ft. from N. Line

*330*

----- Ft. from S. Line

----- Ft. from E. Line

*990*

----- Ft. from W. Line


Location

Rig up -----

Drilling and Remarks:

**RECORD**

Cased ----- in., ----- ft.

Sand -----

Gas *flame all* -----

Oil -----

Total Depth -----

**PRODUCTION**

1st 24 hrs. Nat. -----

1st 24 hrs. after shot -----

Gas ----- Cu. Ft.

Dry Hole -----

Abandoned -----

Date

**FEB 15 1928**

**CHAS. L. SHERWOOD**

192

Scout

*Cowley*

Map No. 2 **KANSAS** Sec. 30 Twp. 31 R. 6<sup>E</sup>

Well No. 1 *Pierce*

*Lewis Producing Co* Company

Contractor

**COMPLETED**

**SECTION PLAT**

----- Ft. from N. Line

330 Ft. from S. Line

----- Ft. from E. Line

990 Ft. from W. Line


Location -----

Rig up -----

Drilling and Remarks:

*807 25 Bbls Oil  
5 Bbls water*

**RECORD**

Cased \_\_\_\_\_ in., \_\_\_\_\_ ft.

Sand 2968-2970

Gas -----

Oil -----

Total Depth 2979'

**PRODUCTION**

1st ~~2~~ hrs. Nat. -----

1st 24 hrs. after shot -----

Gas ----- Cu. Ft.

Dry Hole -----

Abandoned -----

Date

**APR 19 1928**

**CHAS. L. SHERWOOD**

192

Scout