


Cowley Co

Map No. Kansas Sec. 5 Twp. 31 R. 6

Well No. 2 Eastman Farm
Showver & Sutter Company

NORTH

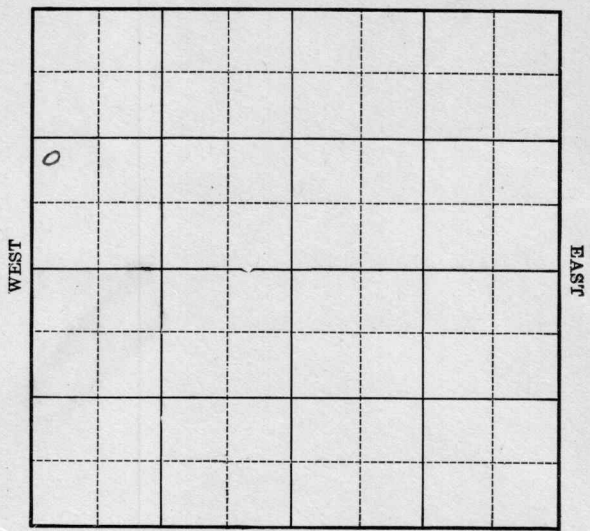

SOUTH

Location _____

Drilling Remarks _____

Rig Up _____

Drilling Remarks _____

RECORD

Cased _____ in. _____ ft.
Sand _____
Gas _____
Oil _____
Total Depth _____

PRODUCTION

1st 24 hrs. Nat. _____
1st 24 hrs. after shot _____
Gas _____ cu. ft.
Dry Hole _____
Abandoned _____


Cowley Co

Map No. Kansas Sec. 5 Twp. 31 R. 6

Well No. 2 Eastman Farm

Showver + Shetter Company

NORTH

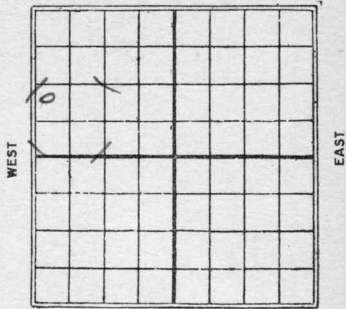

..... Ft. from N. Line

1020 Ft. from S. Line

..... Ft. from E. Line

250 Ft. from W. Line

Date	REPORT
<u>1925</u>	
11/19	Location
11/27	—
12/3	—
12/10	—
12/17	—
12/23	—
12/31	—
<u>1926</u>	
1/8	Bldg rig
1/14	Rig
1/20	Drilg 400'
1/27	—
2/4	—
2/10	—
2/17	Drilg 2200'
2/24	—
3/5	J. 2796. Pulling big
	Pipes.
2/10	5" 2792-J. S. 2796 1st air
	2815-38 Shale Break
	2838-42 Pay. 2842-56
	J. O. filled up 600' 48
	hours will shoot.

2/18 Sand 2792-2856
60 gts 20 oil 20 water

Cowley Co

Map No. *K2* KANSAS Sec. *5* Twp. *31* R. *6*

Well No. *2* *Eastman*

Shawver & Sutter Company

Contractor

FIRST REPORTS

SECTION PLAT

_____ Ft. from N. Line

1020 Ft. from S. Line

_____ Ft. from E. Line

250 Ft. from W. Line

<i>10</i>			

Location

Rig up _____

Drilling and Remarks:

RECORD

Cased _____ in., _____ ft.

Sand _____

Gas _____

Oil _____

Total Depth _____

PRODUCTION

1st 24 hrs. Nat. _____

1st 24 hrs. after shot _____

Gas _____ Cu. Ft.

Dry Hole _____

Abandoned _____

Date

NOV 19 1925

192

CHAS. L. SHERWOOD

Scout

Map No. K2 KANSAS Sec. 5 Twp. 31 R. 6

Well No. 2 Eastman
Shawver & Sutton Company

Contractor

COMPLETED

SECTION PLAT

----- Ft. from N. Line

1020 Ft. from S. Line

----- Ft. from E. Line

250 Ft. from W. Line

Location -----

Rig up -----

Drilling and Remarks:

Oil 2815-2838'
Shab 2838-42'
Day 20 2842-56'
bay 20 lbs oil,
20 lbs water.

RECORD

Cased _____ in., _____ ft.
 Sand 2792-2856'
 Gas -----
 Oil -----
 Total Depth 2856'

PRODUCTION

1st 24 hrs. Nat. -----
 1st 24 hrs. after shot. -----
 Gas ----- Cu. Ft.
 Dry Hole -----
 Abandoned -----

Date

MAR 18 1926

192

CHAS. L. SHERWOOD

Scout