


Section 36 Township 18 Range 11 W

Well No. # 2 Musenberg

Company B & B Drlg.

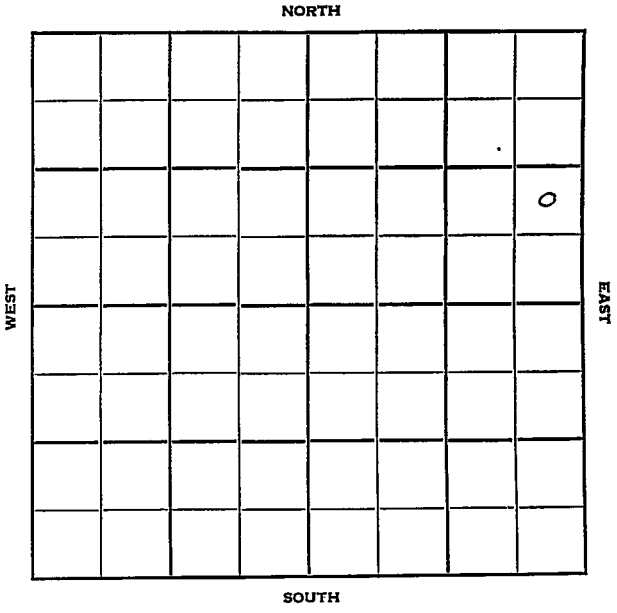

Sec. 36 Twp. 18 R. 11W

Well No. #2 Musenberg Farm

B & B Drlg. Company

B & B Drlg. - Contr. Contractor

Mary Ida Pool


_____ Ft. from N. Line

990' Ft. from S. Line

330' Ft. from E. Line

_____ Ft. from W. Line

NE SE NE

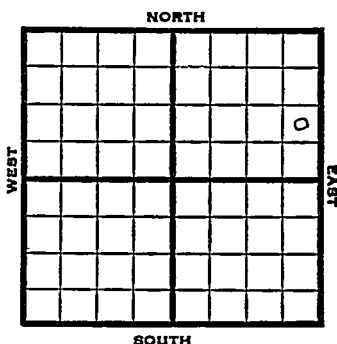

1951

Elev. 1719'

REPORT

4/11 RUR

6/13

Spud 4-9-51
 Oil well TD 3333' 8" @ 178
 Anhy 490-515 Top 2560' Heeb 2825'
 Doub 2854' Br. lime 2943' KC 2962
 DST 3033-41 open 1/2 hr. rec 2460' oil
 DST 3044-56 open 10 min. rec 240' mud
 & free oil
 Arb. 3324' 5" @ 3300 TD 3333'
 46/3047-55 1000 A F/56 BOPH
 Comp. 512 BOPD

COMPLETED

