


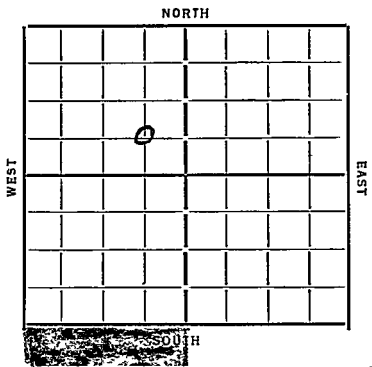

Barton

Map No. KANSAS Sec. 36 Twp 18 R. 11<sup>W</sup>  
Well No. 1 Straub Farm  
Atlantic Oil Prod. Company

         Ft. from N. Line  
660 Ft. from S. Line  
660 Ft. from E. Line  
         Ft. from W. Line



"SPECIAL"

Date

REPORT

1954	
5/23	Location
5/21	Blk. Req
6/7	Rign up
6/14	Spud 200 15 1/2 175
6/21	Blg 1130
6/28	" 1340 12 1/2 1225
7/5	" 2040
7/12	" 2465 10" 2332
7/19	898 2991 T Lancing 2984
	Blg 3066 (7/26 6" 3168 T Cong 3250 S.O. 3262-65 D19REP)
7/27	Top Siliceous line 3286
	5" 3286 TD 3298
	Best Pay 3294-3296
	Bailing 3 1/2 Bailer 7 oil per hr thru mud &avings
	Pipe now set in hole Will let set 6 hrs & then start swabbing (Tel)
7/28	Top Siliceous line 3286
	Blg 3306 Swabbed hole dry let set 3 1/2 hrs & filled up 100 feet 7 oil (Tel)

7/30 TD 3313  
400 feet oil & trace of  
water Plugging back 1 foot  
(Tellegen)

8/2 T Siliceous 3286  
Oil 3294-96 TD 3313  
trace water PB

8/9 PB 3310 acidizing

8/10 45 Bbls oil & 15 water  
after acid

8/22 Siliceous 3286 TD 3313  
PB 3310 acidized  
45 oil 15 water

COMPLETED

*Boston*  
Form 26 - 11 M Bks. - 2-24

KANSAS

Map No. 55 Sec. 36 Twp. 18 R. 11W

Well No. 1-Straub

Atlantic Oil Company

Contractor

**COMPLETED**

**SECTION PLAT**

	0		

\_\_\_\_\_ Ft. from N. Line

660 Ft. from S. Line

660 Ft. from E. Line

\_\_\_\_\_ Ft. from W. Line

Location \_\_\_\_\_

Rig up \_\_\_\_\_

Drilling and Remarks:

*P.B. 3310  
subsd.  
  
45 oil  
15 water*

**RECORD**

Cased \_\_\_\_\_ in., \_\_\_\_\_ ft.  
Sand siliceous 3286  
Gas \_\_\_\_\_  
Oil \_\_\_\_\_  
Total Depth 3313

**PRODUCTION**

1st, 24 hrs. Nat. \_\_\_\_\_  
1st 24 hrs. after shot \_\_\_\_\_  
Gas \_\_\_\_\_ Cu. Ft.  
Dry Hole \_\_\_\_\_  
Abandoned \_\_\_\_\_

Date

8-22-34 19

**ORVAL MANNSCHRECK**

Scout

Map No. 55 Sec. 36 Twp. 18 R. 11W

Well No. 1-Straub

Atlantic Oil Prod Company

Contractor

FIRST REPORTS

SECTION PLAT

	0		

\_\_\_\_\_ Ft. from N. Line

660 Ft. from S. Line

660 Ft. from E. Line

\_\_\_\_\_ Ft. from W. Line

SPECIAL

Location V

Rig up \_\_\_\_\_

Drilling and Remarks:

RECORD

Cased 2 1/2 in., \_\_\_\_\_ ft.

Sand east

Gas \_\_\_\_\_

Oil \_\_\_\_\_

Total Depth \_\_\_\_\_

PRODUCTION

1st 24 hrs. Nat. \_\_\_\_\_

1st 24 hrs. after shot \_\_\_\_\_

Gas \_\_\_\_\_ Cu. Ft.

Dry Hole \_\_\_\_\_

Abandoned \_\_\_\_\_

Date

5-23-34 19

ORVAL MANNSCHRECK

Scout