


Map No. **KANSAS** Sec. 30 Twp. 31 R. 6E
 Well No. 45 Pierce "A" Farm _____
Lewis Prob. Company _____

NORTH

WEST

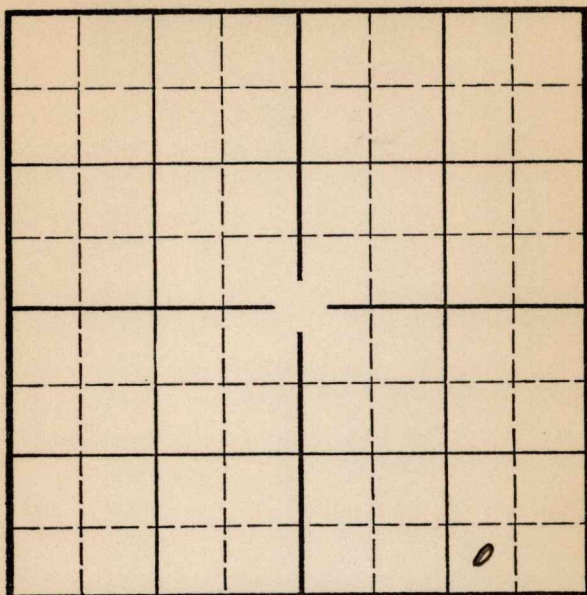

EAST

SOUTH

Location _____
 Drilling Remarks _____

Rig Up _____
 Drilling Remarks _____

RECORD

Cased _____ in. _____ ft.
 Sand _____
 Gas _____
 Oil _____
 Total Depth _____

PRODUCTION

1st 24 hrs. Nat. _____
 1st 24 hrs. after shot _____
 Gas _____ cu. ft. _____
 Dry Hole _____
 Abandoned _____

Cowley

KANSAS

Map No. _____ Sec. 30 Twp. 31 R. 6E

Well No. 47 Pierce 'A' Farm _____

Lewis Prob

Company _____

NORTH

WEST

EAST

SOUTH

_____ Ft. from N. Line

330

_____ Ft. from S. Line

930

_____ Ft. from E. Line

_____ Ft. from W. Line

Elev. 1378

REPORT

Date		
1935		
12/4	Rgn	15" 460
12/13	Alg 1150	12" 1055
12/19	" 1780	10" 1458 8" 1666
12/26		
12/36	Top Part 2947	
	80 gts 2913-47	
1/8	Swabg Co	
	Part 2879	
	TD 2947	
	80 gts 60 Oil	

COMPLETED

Map No. 2 Sec. 30 Twp. 31 R. 6E

Well No. 4- Pierce 'A'

Lewis Prod. Company

Contractor

FIRST REPORTS

SECTION PLAT

Ft. from N. Line

330 Ft. from S. Line

930 Ft. from E. Line

Ft. from W. Line

			0

Location

Rig up

Drilling and Remarks:

Run

RECORD

Cased in, ft.

Sand

Gas

Oil

Total Depth

PRODUCTION

1st 24 hrs. Nat.

1st 24 hrs. after shot

Gas Cu. Ft.

Dry Hole

Abandoned

Date

12-4-35

192

Scout

ORVAL MANNSCHECK

KANSAS

Map No. 2 Sec. 30 Twp. 31 R. 6E

Well No. 4 Pierce "A"

Lewis Prod Company

Contractor

SECTION PLAT

Ft. from N. Line

330 Ft. from S. Line

930 Ft. from E. Line

Ft. from W. Line

COMPLETED

			0

Location

Rig up

Drilling and Remarks:

80 gts

60 oil

RECORD

Cased in., ft.

Sand But 2879

Gas

Oil

Total Depth 2947

PRODUCTION

1st 24 hrs. Nat.

1st 24 hrs. after shot

Gas Cu. Ft.

Dry Hole

Abandoned

Date

JAN 8 1936 192 ORVAL MANNSCHRECK Scout