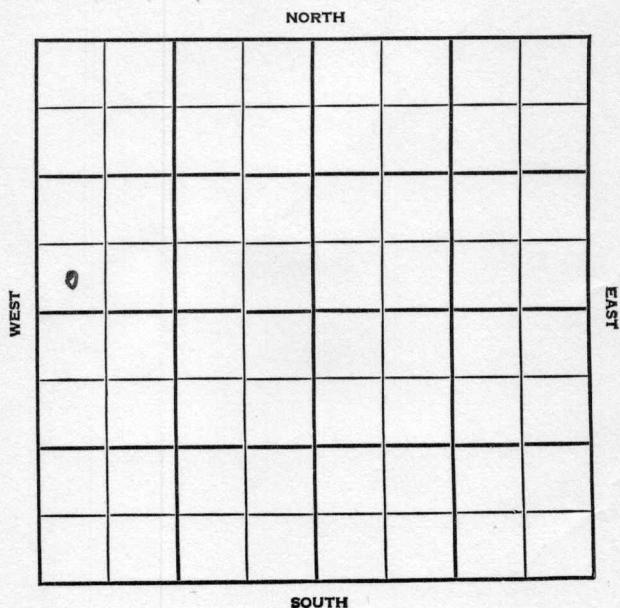


Section 5 Township 31 Range 6EWell No. 5 Eastman "A"Company H. H. Blair

Cowley KANS S

SEC.	TWP.	R.
5	31	6E

WELL NO.

5 Eastman "A" FARM

COMPANY

H. H. Blair

CONTRACTOR

Kriswell


Eastman Pool

Ft. from N. Line

330 Ft. from S. Line

Ft. from E. Line

330 Ft. from W. Line

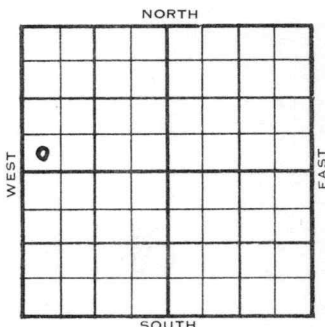

SW SW NW

ELEVATION	REPORT
1954 1333'	

11/17 Location

1955
1/26

Spud 11-27-54 Oil well TD 2889
8-5/8" @ 99 KC 2163 Bart. 2796
Bart. sd 2810 Miss. 2887
TD 2889 5" @ 2887 C/O to 2870
38/2810-18 frac.
Comp. 25 BOPD

COMPLETED

County Cowley State Kansas

Sec. **5** (Blk. **31** (Sur. **6E** Map No.

Operator **H. H. Blair**

Well No. **5** Farm **Eastman "A"**

Elev.	Location	SW	SW	NW
-------	----------	----	----	----

[illegible]

330 Ft. From S Line NW

330 Ft. From W Line Quarter

1st. Report NOV 17 1954

Completion

Remarks


Kriswell - Contr.

Spudding Date _____

Drlg. Data Eastman Pool

Location

FABEN GILSTRAP

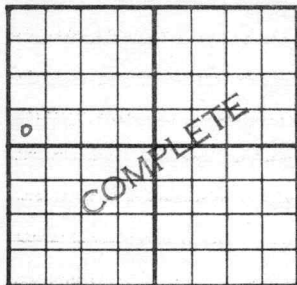County Cowley State KansasSec. 5 (Blk.) 31 (Sur.) 6E Map No.Operator H. H. BlairWell No. 5 Farm Eastman "A"Elev. 1333 Location SW SW NW330 Ft. From S Line NW330 Ft. From W Line Quarter

1st. Report

Completion JAN 26 1955Remarks Eastman PoolKriswell - Contr.Spudding Date 11-27-54Drlg. Data Oil well TD 28898 5/8" @ 99 KC 2163 Bart. 2796Bart. sd. 2810 Miss. 2887 TD 28895" @ 2887 CO to 2870 38/ 2810-18frac Comp. 25 bopd

FABEN GILSTRAP