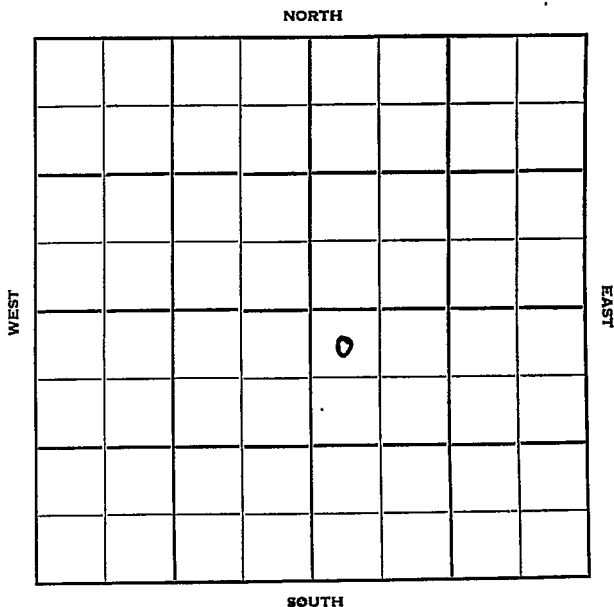


Section 36 Township 18 Range 11 WWell No. # 5 DollCompany Sohio

Sec. 36 Twp. 18 R. 11W

Well No. #5 Doll Farm

Sohio Company

Contractor


330 Ft. from N. Line

Ft. from S. Line

Ft. from E. Line

330 Ft. from W. Line

NW NW SE

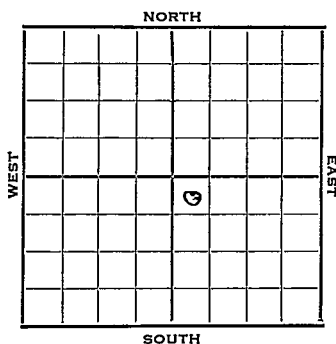

1952 Elev. 1752' REPORT

5/28 Location
6/11 Topeka 2564'
DST 2767-85, 1 hr, 180' HOCM
120' OCSW 830#
Heeb 2829'
Drlg. 2910'

6/18 Dodge 2853 Br Li 2949
Lans. 2967
DST 3022-46 21 mins
F oil 21 mins 1140' oil 805#
Arb. 3274 RTD 3281
5" @ 3276' WOCT

6/25 Spud 5-3-52
Oil Well TD 3281
8" @ 500' Top. 2564
DST 2767-85 open 1 hr. rec. 180' gocm
120' ocsW Heeb. 2829 Dodge 2853
Br Li 2949 Lans. 2967
DST 3022-46 open 21 min. F/ oil
21 min. 1140' oil Arb. 3274
TD 3281 5" @ 3276 CO to 3244
2o/ 3035-39 12/ 3021-24 2000 A
F/ 17 bo 1 hr. F/ 28 boph
Comp. 868 bopd


COMPLETED

County **Barton** State **Kansas**
 Sec. **36** (Blk. Twp.) **18** (Sur. Rge.) **11W** Map No.

Operator **Sohio**

Well No. **5** Farm **Doll**

Elev. Location **NW NW SE**

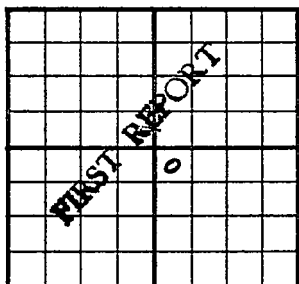

330 Ft. From **N** Line **SE**

330 Ft. From **W** Line Quarter

1st. Report **MAY 28 1952**

Completion

Remarks

Spudding Date

Drlg. Data

Location

J. G. McGEHEE

J. G. McGEHEE