


Section 36 Township 18 Range 11 WWell No. # 1 JohanningCompany S. M. Anderson

NORTH

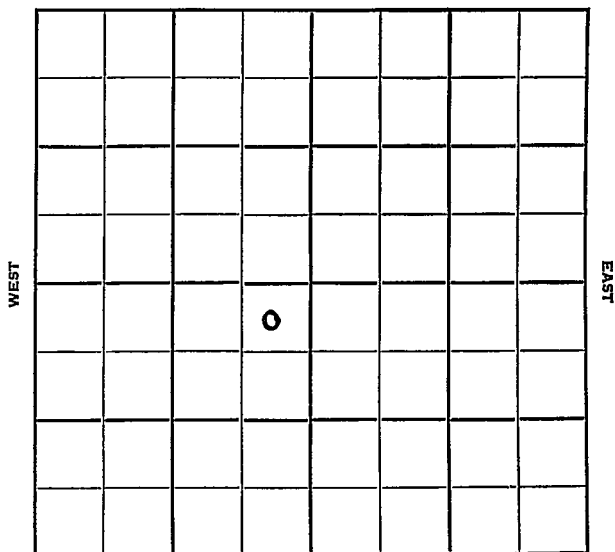

SOUTH

Barton KANSAS

Sec. 36 Twp. 18 R. 11 W

Well No. # 1 Johanning Farm

S. M. Anderson Company

Isern Contractor


330 Ft. from N. Line

Ft. from S. Line

330 Ft. from E. Line

Ft. from W. Line

NE NE SW

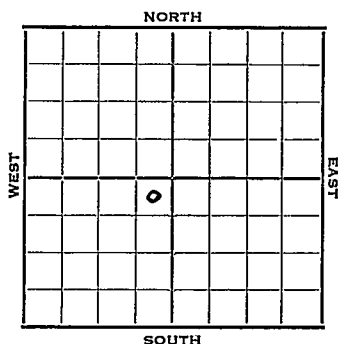

1952	Elev. 1755'	REPORT
3/26	Location	
4/1	"	
4/9	8" @ 193'	
	Anhy 495	
	Dr1g. 1605'	
4/23	Heeb. 2837	Br Li 2955
	Lans. 2978	
	DST 2980-90 40 mins 10' m	O#
	DST 3026-56 1/4 hr. 600' free oil	
	50' OCM 1000#	
	DST 3060-70 1 hr. 12' M	O#
	Cong 3260 Arb. 3283-85 RTD	
	5" @ 3284'	
4/30	CO 3262'	32/ 3029-41 1000 A
	S&F 20 BO 1 hr.	
5/7	NR	
5/14	"	
5/21	"	
5/28	"	
6/11	Spud 4-5-52	
	Oil Well TD 3285'	8" @ 193'
	Anhy 495'	Heeb. 2837
	Br Li 2955	Lans. 2978
	DST 2980-90 open 40 min. rec. 10' mud	
	DST 3026-56 open 15 min. rec. 600'	
	free oil 50' ocm	

OVER

County Barton State Kansas
 Sec. 36 (Blk. Twp.) 18 (Sur. Rge.) 11W Map No.

Operator S. M. Anderson

Well No. 1 Farm Johanning

Elev. _____ Location NE NE SW

FIRST REPORT

0

350 Ft. From N Line SW

350 Ft. From E Line Quarter

1st. Report MAR 26 1952

Completion _____

Remarks _____


Isern - Contr.

Spudding Date _____

Drlg. Data _____

Location

J. G. McGEHEE

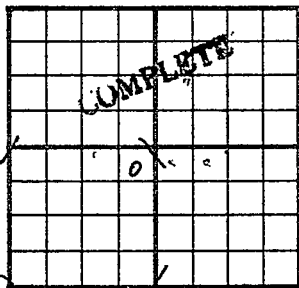County Barton State KansasSec. 36 (Blk.
Twp.) 18 (Sur.
Rge.) 11W Map No.Operator S. M. AndersonWell No. 1 Farm JohanningElev. 1755 Location NE NE SW330 Ft. From N Line SW330 Ft. From E Line Quarter

1st. Report

Completion JUN 11 1952

Remarks

Isern - Contr.Spudding Date 4-5-52Drilg. Data Oil well TD 32858" @ 193 Anhy 495 Heeb. 2837Br. lime 2955 Lans. 2978 DST 2980-90open 40 min. Rec. 10' mud DST 3026-56open 15 min. Rec. 600' free oil 50' ocmDST 3060-70 open 1 hr. Rec. 12' mudCong. 3260 Arb. 3283-85 5" @ 3284CO to 3262 32/ 3029-41 1000 AS & F/ 20 boph Comp. 581 bopd

J. G. McGEHEE

1952

6/11 DST 3060-70 open 1 hr. rec. 12' mud
Cong. 3260 Arb. 3283-85
5" @ 3284' CO to 3262 32/ 3029-41
1000' A S&F/20 boph
Comp. 581 bopd

COMPLETED