


Barton

Section 36 Township 18 Range 11 W

Well No. # 1 Musenberg

Company B & B Drlg.

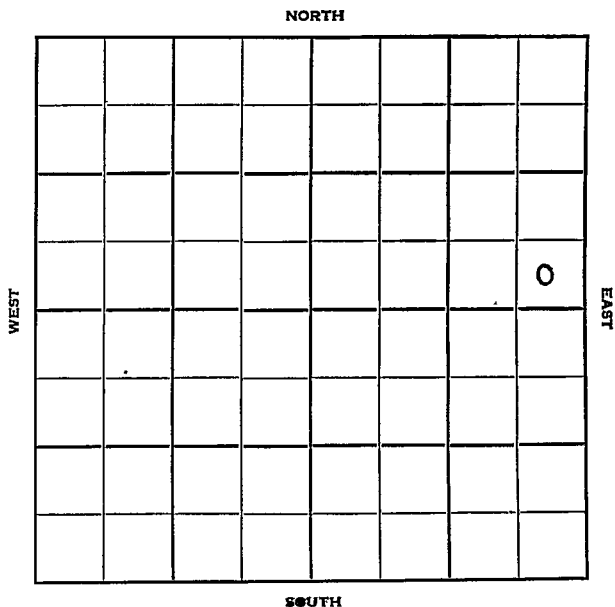

Sec. 36 Twp. 18 R. 11W

Well No. #1 Musenberg Farm

B & B Drlg. Company

B & B Drlg. - Contr. Contractor


\_\_\_\_\_ Ft. from N. Line

330' Ft. from S. Line

330' Ft. from E. Line

\_\_\_\_\_ Ft. from W. Line

SE SE NE

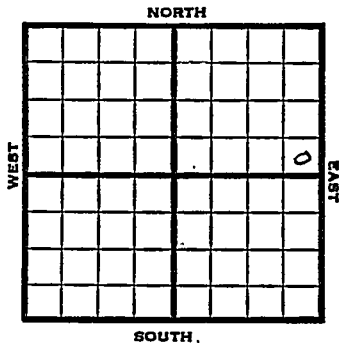

1951 Elev. 1757' REPORT

2/14 Location

4/11 Spud 2-17-51  
 Oil well TD 3306'  
 8" @ 157 Anhy 500' Top 2560'  
 Heeb 2826' Br. lime 2944' Lans 2964'  
 DST 3032-47 open 20 min. rec 450' oil  
 DST 3101-15 open 20 min. rec 800' oil  
 DST 3101-15 open 30 mins. rec 150' OCM  
 DST 3135-54 open 35 min. rec 65' O&GCM  
 Cong 3265' Arb 3301-06'  
 5" @ 3303 TD 3306' S/2 BOPH  
 SP 3170' 47/3136-52 2000 A  
 S/15 BO 5 BWPB  
 Comp. 516 BOPD

**COMPLETED**

County Barton State Kansas

Sec. 36 (Blk. Twp.) 18 (Sur. Rge.) 11W Map No.

Operator B & B Drlg.

Well No. 1 Farm Musenberg

Elev. \_\_\_\_\_ Location SE SE NE

FIRST REPORT							
							0

330 Ft. From S Line NE

330 Ft. From E Line Quarter

1st. Report FEB 14 1951

Completion \_\_\_\_\_

Remarks \_\_\_\_\_

B & B Drlg. - Contr.

Spudding Date \_\_\_\_\_

Drlg. Data \_\_\_\_\_

Location

J. E. TYRA

