

Map No. KANSAS Sec. 32 Twp. 37 R. 6

Well No. 1- Bruce Farm

Lewis Prod Co Company

WEST

EAST

SOUTH

Location _____

Drilling Remarks

Rig Up _____

Drilling Remarks

RECORD

Cased _____ in. _____ ft.

Sand _____

Gas_____

Oil _____

Total Depth_____

PRODUCTION

1st 24 hrs. Nat. _____

1st 24 hrs. after shot_____

Gas_____cu. ft._____

Dry Hole_____

Abandoned _____

Map No. **KANSAS** Sec. 30 Twp. 31 R. 6^E
 Well No. 1- Pierce Farm
Lewis Prod Co Company


330 Ft. from N. Line

_____ Ft. from S. Line

_____ Ft. from E. Line

990 Ft. from W. Line

1929

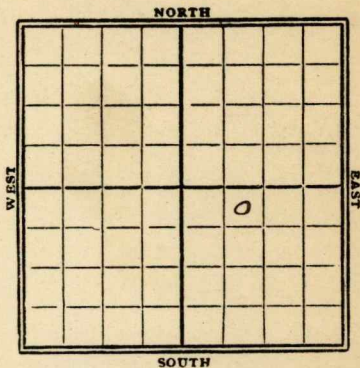

Date

REPORT

7/17 Location

7/24 Run up

7/31 Only 1600'

8/7 " 1095'

8/14 " 2027'

8/21 " 2500

8/28 sand 2907-51

shot 100 gals - C.C.

9/4 sand 2907-51'

TD 2951'

shot 100 qt

60 bbl oil

Comp.

Map No. **KANSAS** Sec. 30Twp. 31R. 6^EWell No. 1Company PierceContractor Lewis Producing Co**FIRST REPORTS**330 Ft. from N. Line

_____ Ft. from S. Line

_____ Ft. from E. Line

990 Ft. from W. Line**SECTION PLAT**

		0	

Location ✓

Rig up _____

Drilling and Remarks:

RECORD

Cased _____ in., _____ ft.

Sand _____

Gas _____

Oil _____

Total Depth _____

PRODUCTION

1st 24 hrs. Nat. _____

1st 24 hrs. after shot _____

Gas _____ Cu. Ft.

Dry Hole _____

Abandoned _____

Date

JUL 17 1929**CHAS. L. SHERWOOD**

19

Scout

Cowley

Map No. **KANSAS** Sec. 30 Twp. 31 R. 6Well No. 1 fiereLewis producing co Company

Contractor

COMPLETE**SECTION PLAT**

		o	

330 Ft. from N. Line

_____ Ft. from S. Line

_____ Ft. from E. Line

990 Ft. from W. Line

Location _____

Rig up _____

Drilling and Remarks:

100/60 Bbs.**RECORD**

Cased _____ in., _____ ft.

Sand 2907-2951'

Gas _____

Oil _____

Total Depth 2951'**PRODUCTION**

1st 24 hrs. Nat. _____

1st 24 hrs. after shot _____

Gas _____ Cu. Ft.

Dry Hole _____

Abandoned _____

Date

SEP 4 1929

CHAS. L. SHERWOOD

19

Scout