

Cowley

Form 51-5M-4-27-27423

Map No. **KANSAS** Sec. 30 Twp. 31 R. 6

Well No. 2 Pierce Farm
Lewis Prod. Co. Company

NORTH

WEST

EAST

SOUTH

Location

Drilling Remarks

Rig Up

Drilling Remarks

RECORD

Cased in. ft.

Sand

Gas

Oil

Total Depth

PRODUCTION

1st 24 hrs. Nat.

1st 24 hrs. after shot

Gas cu. ft.

Dry Hole

Abandoned


Map No. **KANSAS** Sec. 30 Twp. 31 R. 6
 Well No. 2 Pierce Farm
Lewis Producing Company

990 Ft. from N. Line

_____ Ft. from S. Line

_____ Ft. from E. Line

330 Ft. from W. Line

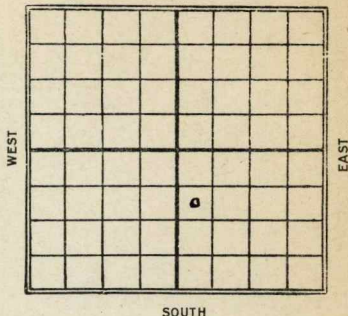

1928

Date	REPORT
9/19	Rigging up
9/26	Spdy 285'
10/3	2 Oreg 480'
10/10	" 1885'
10/17	" 2560'
10/24	sand 2923-58'
	shot 40 gts
	10 bbls oil, 5 bbls water
10/31	sand 2923-58'
	T.D. 2958'
	shot 40 gts
	10 bbls oil
	Sump

K2 KANSAS

MAP No. _____ SEC. 30 TWP. 31 R. 6WELL No. 2Pierce
Lewis Producing Co COMPANY

CONTRACTOR

FIRST REPORTS

SECTION PLAT

		0	

990 FT. FROM N. LINE

_____ FT. FROM S. LINE

_____ FT. FROM E. LINE

330 FT. FROM W. LINE

LOCATION _____

RIG UP _____

DRILLING AND REMARKS:

Rigging up

RECORD

CASED _____ IN. _____ FT.

SAND _____

GAS _____

OIL _____

TOTAL DEPTH _____

PRODUCTION

1ST 24 HRS. NAT. _____

1ST 24 HRS. AFTER SHOT _____

GAS _____ Cu. Ft.

DRY HOLE _____

ABANDONED _____

DATE

SEP 19 1928

CHAS. L. SHERWOOD

192

SCOUT

K2 KANSAS

MAP No. _____ SEC 30 TWP. 31 R. 6WELL No. 2 PierceLewis Producing COMPANY

CONTRACTOR

COMPLETED

SECTION PLAT

		0	

990 FT. FROM N. LINE

_____ FT. FROM S. LINE

_____ FT. FROM E. LINE

330 FT. FROM W. LINE

LOCATION _____

RIG UP _____

DRILLING AND REMARKS:

40/10 AB6

RECORD

CASED _____ IN. _____ FT.

SAND 2923-2958

GAS _____

OIL _____

TOTAL DEPTH 2958

PRODUCTION

1ST 24 HRS. NAT. _____

1ST 24 HRS. AFTER SHOT _____

GAS _____ CU. FT.

DRY HOLE _____

ABANDONED _____

DATE

OCT 31 1928

CHAS. L. SHERWOOD

192

SCOUT