


Section 36 Township 18 Range 11W

Well No. #3 Musenberg

Company B & B Drlg.

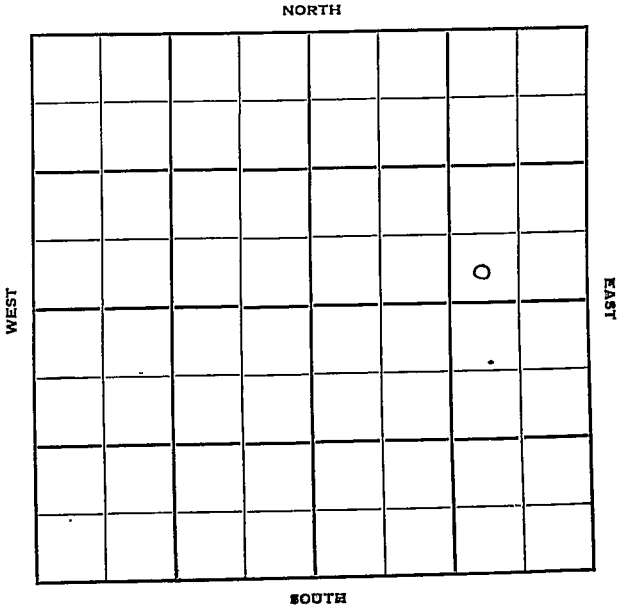

Barton

ANSAS

Sec. 36 Twp. 18 R. 11 W

Well No. # 3 Musenberg Farm

B & B Drlg. Company

Contractor

Mary Ida Pool


Ft. from N. Line

330 Ft. from S. Line

990 Ft. from E. Line

Ft. from W. Line

SW SE NE

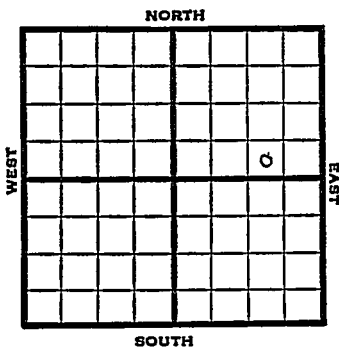

1951	Elev. 1753' REPORT
8/15	Drlg.
9/12	Spud 8-11-51 Oil well TD 3309' 8" @ 205 Anhy 500' KC 2970' DST 2970-3046 open 12 min. rec 1560' mud & free oil DST 3050-59 open 6 min. gas in 4 min. rec 150' oil Arb. 3285-89' 5" @ 3288' TD 3299' SSO 750 A S/3 BOPH dec. to 1 BOPH DD 3309' 1000 A S/8 BOPH Comp. 256 BOPD
	COMPLETED

County **Barton** State **Kansas**

Sec. **36** (Blk. Twp.) **18** (Sur. Rge.) **11W** Map No.

Operator **B & B Drlg.**

Well No. **3** Farm **Musenberg**

Elev. Location **SW SE NE**


**330** Ft. From **S** Line **NE**  
**990** Ft. From **E** Line Quarter

Ist. Report **AUG 15 1951**

Completion

Remarks

Spudding Date

Drlg. Data **Mary Ida Pool**  
**drlg.**

