


Section 36 Township 18 Range 11W

Well No. #5 Musenberg

Company B & B drlg.

NORTH

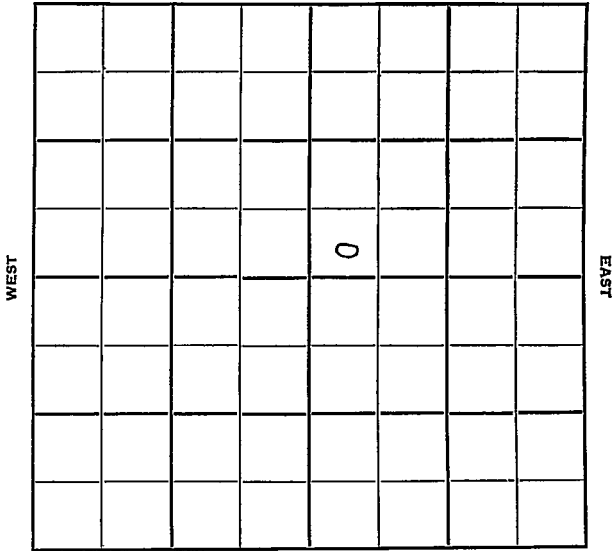

SOUTH

WEST

EAST

Sec. 36 Twp. 18 R. 11 W

Well No. # 5 Musenberg Farm

B & B Drlg. Company

B & B Contractor


         Ft. from N. Line

330 Ft. from S. Line

         Ft. from E. Line

330 Ft. from W. Line

SW SW NE

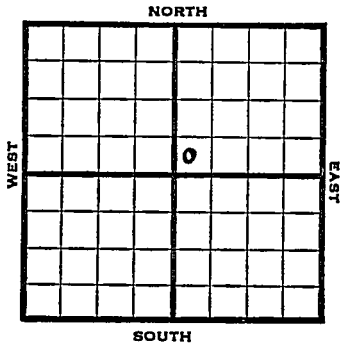

1952

Elev. 1748'

REPORT

5/21

Spud 5-15-52  
8" @ 158' Anhy 485'  
Drlg. 2535'

5/28

Spud 5-15-52  
D&A TD 3328' 8" @ 158'  
Anhy 485' Heeb. 2833  
Lans. 2969  
DST 2972-3050 open 1 hr. rec. 150' SGCM  
Cong. 3250 TD 3328  
D&A

**ABANDONED**



