

Paulley

Map No. **KANSAS** Sec. 30 Twp. 31 R. 6

Well No. 1 - Sutton Farm
Lewis Prod Co Company


_____ Ft. from N. Line

330 Ft. from S. Line

_____ Ft. from E. Line

990 Ft. from W. Line

1929

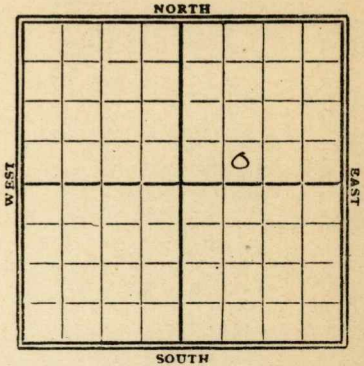

Date	REPORT
------	--------

4/17	Regrin up.
4/24	Spdy
5/11	Drift 500'
5/18	" 2200'
5/15	" 2883'
5/22	sand 2905-46'
	T.D. 2955' - shot 80 gts
	Ry burned
5/29	sand 2905-46'
	T.D. 2955
	shot 80 gts
	50 bbls oil
	Pomp.

Map No. **2** **KANSAS** Sec. **30** Twp. **31** R. **6**

Well No. **1** **Sutton**

Lewis Prod Co Company

Contractor

FIRST REPORTS

SECTION PLAT

..... Ft. from N. Line

330 Ft. from S. Line

..... Ft. from E. Line

990 Ft. from W. Line

		o	

Location.....

Rig up.....

Drilling and Remarks:

Rigging up

RECORD

Cased..... in., ft.

Sand.....

Gas.....

Oil.....

Total Depth.....

PRODUCTION

1st 24 hrs. Nat.....

1st 24 hrs. after shot.....

Gas..... Cu. Ft.

Dry Hole.....

Abandoned.....

Date

APR 17 1929

CHAS. L. SHERWOOD

192..... Scout

Cawley

Map No. **KANSAS** Sec. *30* Twp. *31* R. *6*

Well No. *2* *1* *Sutton*
Lewis Prod Co Company

Contractor

COMPLETE

SECTION PLAT

..... Ft. from N. Line

330 Ft. from S. Line

..... Ft. from E. Line

990 Ft. from W. Line

		0	

Location.....

Rig up.....

Drilling and Remarks:

80/50 Bls.

RECORD

Cased..... in., ft.

Sand *2905-2946*

Gas.....

Oil.....

Total Depth *2955*

PRODUCTION

1st 24 hrs. Nat.....

1st 24 hrs. after shot.....

Gas..... Cu. Ft.

Dry Hole.....

Abandoned.....

Date

MAY 29 1929

192.....

CHAS. L. SHERWOOD

Scout