

Map No. **KANSAS** Sec. 30 of 31 R. 6^E

Well No. 1- Suttons Farm

Lewis Prod & Empire Company

NORTH

WEST

EAST

SOUTH

Location _____

Drilling Remarks

Rig Up _____

Drilling Remarks

RECORD

Cased _____ in. _____ ft.

Sand _____

Gas _____

Oil _____

Total Depth _____

PRODUCTION

1st 24 hrs. Nat. _____

1st 24 hrs. after shot _____

Gas _____ cu. ft. _____

Dry Hole _____


Abandoned _____

Map No. **KANSAS** Sec. 30 Twp. 31 R. 6^E

Well No. 1- Littleton Farm

Lewis Prod & Empire Company

NORTH

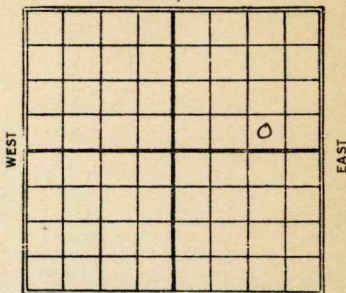

Ft. from N. Line

330 Ft. from S. Line

990 Ft. from E. Line

Ft. from W. Line

SOUTH

Date

REPORT

1929

Date	REPORT
10/23	Bldg Rig
10/30	Spdy.
11/6	drlg 1125'
11/13	515 1826'
11/20	drlg 2485' 6"-2470
11/27	sand 2881-2932'
	500' oil in hole
12/4	sand 2898-2930
	T.D. 2950' shot 80 qt
	Qty out
12/11	sand 2898-2930'
	T.D. 2930'
	shot 80 qt
	30 bbl oil
	comp.

2 **KANSAS**Map No. _____ Sec. 30 Twp. 31 R. 6^EWell No. 1 SuttonLewis Prod & Empire Company

Contractor _____

FIRST REPORTS**SECTION PLAT**

			0

_____ Ft. from N. Line

330 Ft. from S. Line990 Ft. from E. Line

_____ Ft. from W. Line

Location _____

Rig up Blag Rig

Drilling and Remarks: _____

RECORD

Cased _____ in., _____ ft.

Sand _____

Gas _____

Oil _____

Total Depth _____

PRODUCTION

1st 24 hrs. Nat. _____

1st 24 hrs. after shot _____

Gas _____ Cu. Ft.

Dry Hole _____

Abandoned _____

Date

OCT 23 1929**CHAS. L. SHERWOOD**

19

Scout

2 **KANSAS** Sec. 30 Twp. 31 R. 6^E

Well No. 1 *Sutton*
Lewis & Empire Company

Contractor

COMPLETE

SECTION PLAT

Ft. from N. Line

330 Ft. from S. Line

990 Ft. from E. Line

Ft. from W. Line

			0

Location

Rig up

Drilling and Remarks:

80/30 Bls.

RECORD

Cased in, ft.

Sand 2898-2930

Gas

Oil

Total Depth 2950

PRODUCTION

1st 24 hrs. Nat.

1st 24 hrs. after shot

Gas Cu. Ft.

Dry Hole

Abandoned

Date

CHAS. L. SHERWOOD

DEC 1 1 1929

192

Scout