

DX 78-1


Barton

KANSAS

Section 5 Township 18 Range 12 W

Well No. #1 Eveleigh "B"

Company Wlech & Olsson

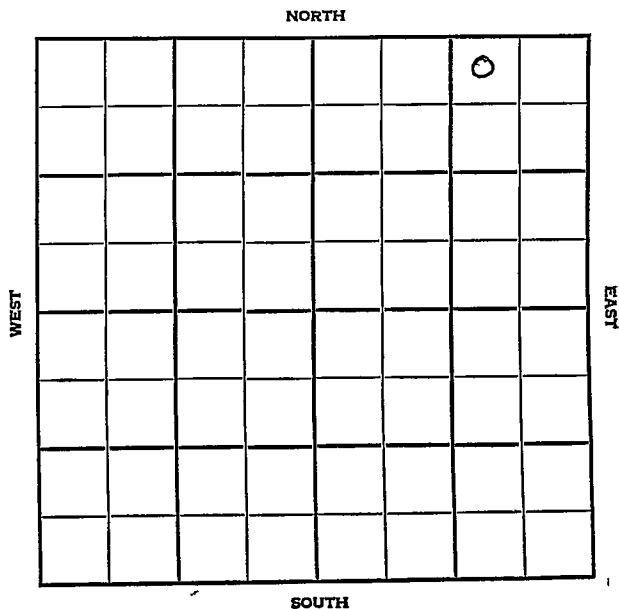

Barton

KANSAS

SEC. 5	TWP. 18	R. 12W
-----------	------------	-----------

WELL NO.

#1 Eveleigh "B"

FARM

COMPANY

Welch & Olsson

CONTRACTOR

Co. Tools

WILDCAT


Ft. from N. Line

Ft. from S. Line

Ft. from E. Line

Ft. from W. Line

NW NE NE

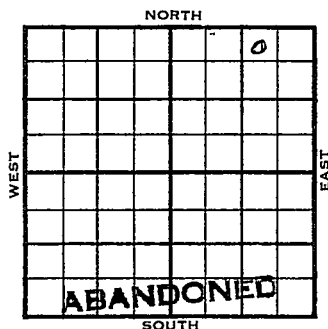

1956

ELEVATION

REPORT

2-29

Comm. 2221-56
 8" @ 238 w/175
 Drlg. 3190
 H. 2996
 BL 2993
 L. 3107

County Barton Elev. _____
 Sec. 5 Twp. 18 Rge. 12W
 Company Welch & Olsson
 FarmName Eveleigh "B" No. 1

Co.

Lse.

No.

Sec.

T.

R.

TOPS DEPTH LOG DATUM

Anh.			
TP.			
H.	2996		
Tr.			
Dg.			
BL.	2993.		
L.	3107		
K.C.			
B.K.C.			
Ce.			
C.			
M.			
M.			
K.			
Mz.			
Me.			
V.			
S.			
S.			
A.			
R.			
Pe.			
G.			
T.D.			

Loc. in Sec.

NW NE NE

Geol.

Contr.

Co. tools

Pool

Wildcat

FIRST REPORT

FEB 29 '56

Date Comm. 2-21-568" @ 238/175 drlg. 3190

-4

County Barton Elev. 1809
 Sec. 5 Twp. 18 Rge. 12W
 Company Welch & Olsson
 Farm Name Eveleigh "B" No. 1

TOPS	DEPTH	LOG	DATUM	Loc. in Sec.
Anh.				NW NE NE
Ip.				
H.	2996			
Tr.				
Dg.				
Bl.	2993		1284	
L.	3107		1298	Geol.
N.C.				
NKC.	3301		1492	Contr.
Ce.				Co. too
C.	3373		1564	
M.				Pool
M.				Wildcat
K.				
Mr.				
Mo.				
V.				
S.				
S.				
A.	3377		1568	ABANDON
R.				
PE.				
G.				MAR 7 '56
TD.	3392			

Date Comm. 2-21-56

8" @ 238/175

dip 3190

MAR 7 '56

20 40910 8' a