

Section 6 Township 18 Range 12 W

Well No. # 1 ~~Fransen~~ Freleigh "B"

Company E. H. Adair & Holly Oil

NORTH

							0

WEST

EAST

SOUTH

Barton

KANSAS

12W

Sec. 6

Twp.

18

R.

Well No.

#1 Eveleigh "B"  
~~#1 Fransen~~

Farm

E. H. Adair & Holly Oil

Company

Contractor

Red Wing Pool

330'

Ft. from N. Line


Ft. from S. Line

330'

Ft. from E. Line

Ft. from W. Line

NE NE NE

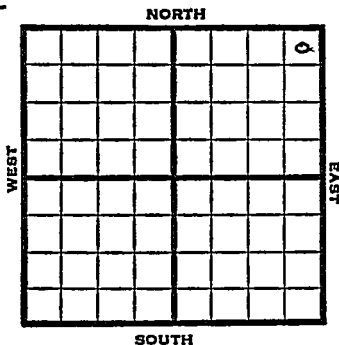

1951

Elev. 1815' REPORT

4/18

RUR

7/3

Spud 4-17-51 D & A TD 3342'  
 8" @ 208' Anhy 705' Heeb 2978'  
 Br. lime 3074' Lans. 3086'  
 Arb. 3339' TD 3342' 5" @ 3340'  
 500 A D & A

ABANDONED


County Barton State Kansas

Sec. 6 (Blk. Twp.) 18 (Sur. Rge.) 12W Map No.

Operator E. H/ Adair & Holly Oil

Well No. 1 Farm Fransen

Elev. \_\_\_\_\_ Location NE NE NE

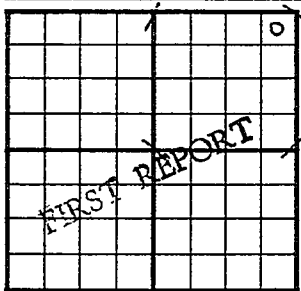

330 Ft. From N Line NE

330 Ft. From E Line Quarter

1st. Report APR 18 1951

Completion \_\_\_\_\_

Remarks \_\_\_\_\_

Spudding Date \_\_\_\_\_

Drlg. Data Red Wing Pool

RUR

J. E. TYRA

Kansas

Map No. \_\_\_\_\_ Sec. 6 Twp. 18 R. 12WWell No. 1 Eveleigh "B"

\_\_\_\_\_ Adair &amp; Holly Oil \_\_\_\_\_ Company

**CORRECTION**

\_\_\_\_\_ Contractor

NE N<sup>th</sup> NE**SECTION PLAT**330 Ft. from N. Line

\_\_\_\_\_ Ft. from S. Line

330 Ft. from E. Line

\_\_\_\_\_ Ft. from W. Line

			0

Barton County

Location \_\_\_\_\_

Rig up \_\_\_\_\_

Drilling and Remarks:

Reported by

Wl Fransen

**RECORD**

Cased \_\_\_\_\_ in., \_\_\_\_\_ ft.

Sand \_\_\_\_\_

Gas \_\_\_\_\_

Oil \_\_\_\_\_

Total Depth \_\_\_\_\_

**PRODUCTION**

1st 24 hrs. Nat. \_\_\_\_\_

1st 24 hrs. after shot \_\_\_\_\_

Gas \_\_\_\_\_ Cu. Ft.

Dry Hole \_\_\_\_\_

Abandoned \_\_\_\_\_

Date

APR 25 1951

19

J. E. TYRA

Scout

County Barton State Kansas

Sec. 6 (Blk. Twp.) 18 (Sur. Rge.) 12W Map No.     

Operator E. H. Adair & Holly Oil

Well No. 1 Farm Fransen Eveleigh "B"

Elev. 1815 Location NE-NE-NE


ABANDONED

330 Ft. From N Line NE

330 Ft. From E Line Quarter

1st. Report     

Completion JUL 3 1951

Remarks Red Wing Pool

Spudding Date 4-17-51

Drlg. Data D & A TD 3342

8" @ 208 Anhy 705 Heeb. 2978

Br. lime 3074 Lans. 3086 Arb. 3339

TD 3342 5" @ 3340 500 A

D & A