

Cowley

Map No. **KANSAS** Sec. 30 Twp. 31 R. 6^E

Well No. 2 Lettew Farm

Lewis Prod Co Company

NORTH


_____ Ft. from N. Line

990 Ft. from S. Line

330 Ft. from E. Line

_____ Ft. from W. Line

1932

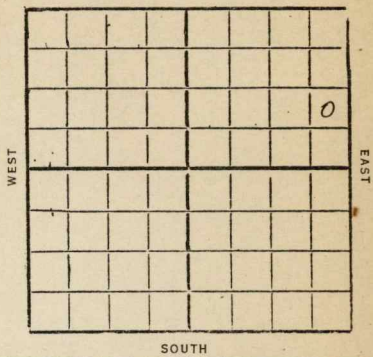

Date

REPORT

3/30 12"-1052
 dreg 1550'
 4/6 6"-2010
 Dreg 2025
 4/13 " 2750
 4/20 Sand 2912-36,
 TD 2936
 shot 50 qt
 flow 150 rpl 24 hr
 Comp.

Cowley

2 KANSAS

Map No. _____ Sec. 30 Twp. 31 R. 6 ^E

Well No. 2 *Sutton*

Lewis pros Co Company

Contractor

FIRST REPORTS

_____ Ft. from N. Line

990 Ft. from S. Line

330 Ft. from E. Line

_____ Ft. from W. Line

SECTION PLAT

| | | | |
|--|--|--|---|
| | | | |
| | | | 0 |
| | | | |
| | | | |

Location _____

Rig up _____

Drilling and Remarks:

dy 1550

RECORD

Cased 12" in., 1052 ft.

Sand _____

Gas _____

Oil _____

Total Depth _____

PRODUCTION

1st 24 hrs. Nat. _____

1st 24 hrs. after shot _____

Gas _____ Cu. Ft.

Dry Hole _____

Abandoned _____

Date

MAR 30 1932

19

CHAS. L. SHERWOOD

Scout

Cawley

E

Map No. **KANSAS** Sec. *30* Twp. *31* R. *6*

Well No. *2* *Sittow*

Lewis Prod Co Company

Contractor

COMPLETED

SECTION PLAT

..... Ft. from N. Line

990 Ft. from S. Line

330 Ft. from E. Line

..... Ft. from W. Line

| | | | |
|--|--|--|---|
| | | | |
| | | | o |
| | | | |
| | | | |
| | | | |

Location

Rig up

Drilling and Remarks:

Shot 50j

*Flow 150. Bbls
in Hours.*

RECORD

Cased in., ft.

Sand *2912-2936*

Gas

Oil

Total Depth *2936*

PRODUCTION

1st 24 hrs. Nat.

1st 24 hrs. after shot

Gas Cu. Ft.

Dry Hole

Abandoned

Date

APR 20 1932 **CHAS. L. SHERWOOD**

192

Scout