


Map No. 75 Sec. 6 Twp. 31 R. 6
Well No. 3 Bardwell Farm
South Western Pet Company

NORTH

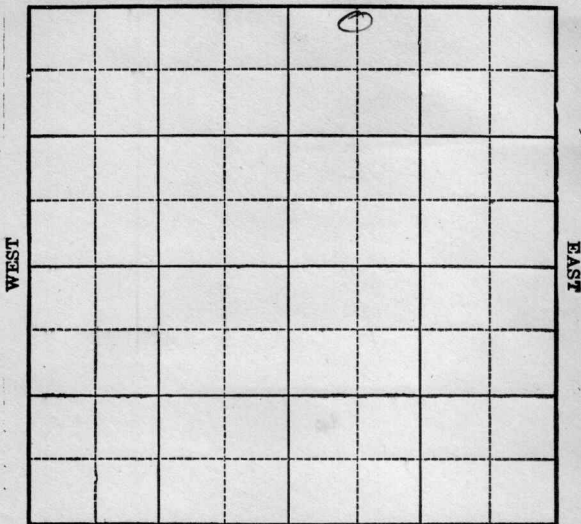

SOUTH

Location _____

Rig up _____

Drilling Remarks:

Drilling Remarks:

RECORD

PRODUCTION

Cased _____ in. _____ ft.

1st 24 hrs Nat. _____

Sand _____

1st 24 hrs. after shot _____

Gas _____

Gas _____ cu. ft.

Oil _____

Dry Hole _____

Total Depth _____

Abandoned _____

Map No. 25 Sec. 6 Twp. 31 R. 6


Well No. 3 Bradwell Farm
Somerset Pet. Company

200 Ft. from N. Line

_____ Ft. from S. Line

_____ Ft. from E. Line

660 Ft. from W. Line

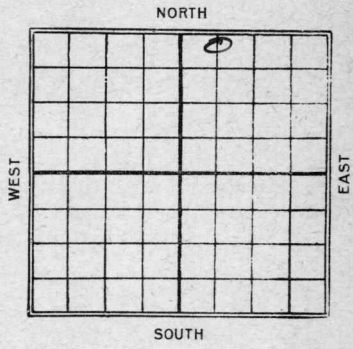

Date	REPORT
1924	
5/22	Roy
7/9	2854- 4 M gas.
	del 2878-2883
	flow 100 Bbls
	del- 600 Bbls water

2 **KANSAS** Map No. Sec. 6 Twp. 31 R. 6

Well No. 3 Bradwell

South Western Pet Company

Contractor

FIRST REPORT

SECTION PLAT

200 Ft. from N. Line

Ft. from S. Line

Ft. from E. Line

660 Ft. from W. Line

		0	

Location

Rig up

Drilling and Remarks:

R.O.G.

RECORD

Cased _____ in., _____ ft.
 Sand _____
 Gas _____
 Oil _____
 Total Depth _____

PRODUCTION

1st 24 hrs. Nat. _____
 1st 24 hrs. after shot _____
 Gas _____ Cu. Ft.
 Dry Hole _____
 Abandoned _____

Date

MAY 22 1924

M. A. BENEAR

192

Scout

Map No. ² **KANSAS** Sec. *30* Twp. *31* R. *6*

Well No. *3 Bordwell*

south western Company

Contractor

COMPLETED SECTION PLAT

200 Ft. from N. Line

----- Ft. from S. Line

----- Ft. from E. Line

660 Ft. from W. Line

		o	

Location -----

Rig up -----

Drilling and Remarks:

*logs 2854-4M
oil 2878-2883
flowing 100 bbl
oil 600 bbl
water*

RECORD

Cased ----- in., ----- ft.
Sand -----
Gas -----
Oil -----
Total Depth -----

PRODUCTION

1st 24 hrs. Nat. -----
1st 24 hrs. after shot -----
Gas ----- Cu. Ft.
Dry Hole -----
Abandoned -----

Date
JUL 9 1924

M. A. BENEAR

----- 192 ----- Scout