


Cowley

KANSAS

Section 31 Township 31 Range 6-E

Well No. 1 Blakey

Company Arthur Brewer

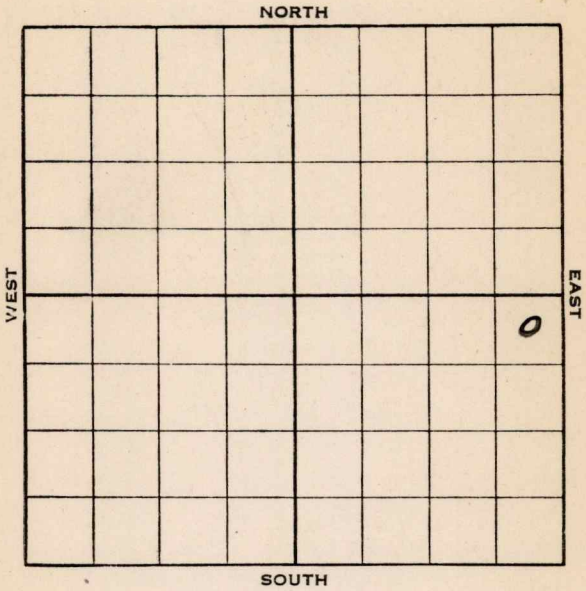

Sec. 31 Twp. 31 R. 6-E


Well No. #1 Blakey Farm _____
Arthur Brewer Company _____

330 Ft. from N. Line

_____ Ft. from S. Line

330 Ft. from E. Line

_____ Ft. from W. Line

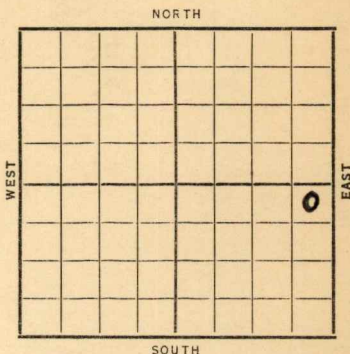

Elev. 1364

Date	REPORT
1938	
7/13	15" - 468'. 12" - 1064'.
	10" - 1497'. Drlg. 1500'.
7/22	10" - 1700'. 8" - 1985'.
	Dlg. 2240'.
7/29	6" - 2431'. Bart. 2924' .
	Est. 1 bbl. oil per hr. 2950-
	2981'. Dlg. 2985'.
8/3	6" at 2431'.
	Bart. 2924' .
	T. D. 2998'.
	4 B.W.P.H.
	ABANDONED

Cowley **KANSAS**

Map No. 2 Sec. 31 Twp. 31 R. 6E

Well No. 1 Blakey

Arthur Brewer Company

Contractor

FIRST REPORT

SECTION PLAT

NE SE

330 Ft. from N. Line

_____ Ft. from S. Line

330 Ft. from E. Line

_____ Ft. from W. Line

			0

Location _____

Rig up _____

Drilling and Remarks:

15" - 468

12" - 1064

10" - 1497

Drlg. 1500

RECORD

Cased _____ in., _____ ft.

Sand _____

Gas _____

Oil _____

Total Depth _____

PRODUCTION

1st 24 hrs. Nat. _____

1st 24 hrs. after shot _____

Gas _____ Cu. Ft.

Dry Hole _____

Abandoned _____

Date

JUL 13 1938 19 H. D. Hatfield Scout

Cowley

Map No. 2 Sec. **31** Twp. **31** R. **6E**

Well No. **1 Blakey**

Arthur Brewer Company

Contractor

ABANDONED

SECTION PLAT

NE SE

330 Ft. from N. Line

_____ Ft. from S. Line

330 Ft. from E. Line

_____ Ft. from W. Line

			0

Location _____

Rig up _____

Drilling and Remarks:

4 BW PH.

DVA

RECORD

Cased 6 in., 2431 ft.

Sand BART 2924

Gas _____

Oil _____

Total Depth 2998

PRODUCTION

1st 24 hrs. Nat. _____

1st 24 hrs. after shot _____

Gas _____ Cu. Ft.

Dry Hole _____

Abandoned _____

Date

AUG 3 - 1938

19

H. D. Hatfield

Scout