


Section 31 Township 31 Range 6 EWell No. # 1 BlakeyCompany Paul McNabb et al

NORTH

WEST

EAST

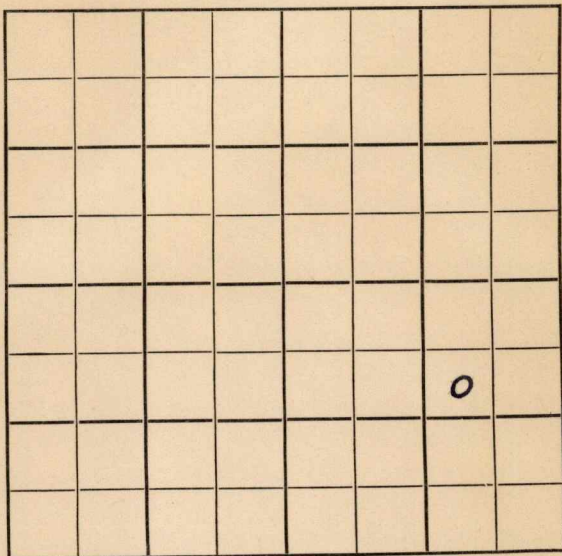

SOUTH

Sec. 31 Twp. 31 R. 6E

Well No. #1 Blakey Farm

Paul McNabb et al _____ Company

Burton Pool Contractor


990 _____ Ft. from N. Line

Ft. from S. Line

990 _____ Ft. from E. Line

Ft. from W. Line

SW NE SE

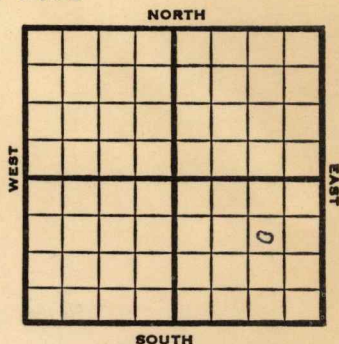

1952

Elev. 1363' REPORT


11/18 8" @ 100'
Drlg. 604'

1953
1/23

D & A	TD 2998'	8" @ 100
KC 2393'	TD 2998'	5" @ 2992
Bart 2978'	CO to 2998'	Hydro
HEW.	D & A	

ABANDONED

County **Cowley** State **Kansas**
Sec. **31** (Bk. **31** (Sur. **6E** Map No.
(Twp.) (Rge.)
Operator **Paul McNabb etal.**
Well No. **1** Farm **Blakey**
Elev. Location **SW NE SE**

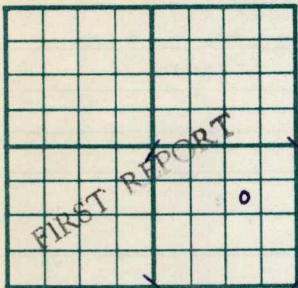990 Ft. From **N** Line **SE**990 Ft. From **E** Line Quarter1st. Report **NOV 19 1952**

Completion


Remarks

Spudding Date

Drlg. Data

Burton Pool**8" @ 100 TD 604**

J. G. McGEHEE

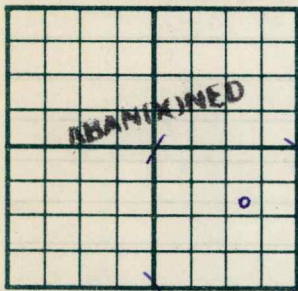County Cowley State KansasSec. 31 (Blk.) 31 (Sur.) 6E Map No.Operator Paul McNabb et al.Well No. 1 Farm BlakeyElev. 1363 Location SW NE SE990 Ft. From N Line SE990 Ft. From E Line Quarter

1st. Report

Completion JAN 23 1953Remarks Burton Pool

Spudding Date

Drlg. Data D & A TD 29988" @ 100 KC 2393 TD 2998 5" @ 2992Bart. 2978 CO to 2998 Hydro. HFWD & A

J. G. McGEHEE