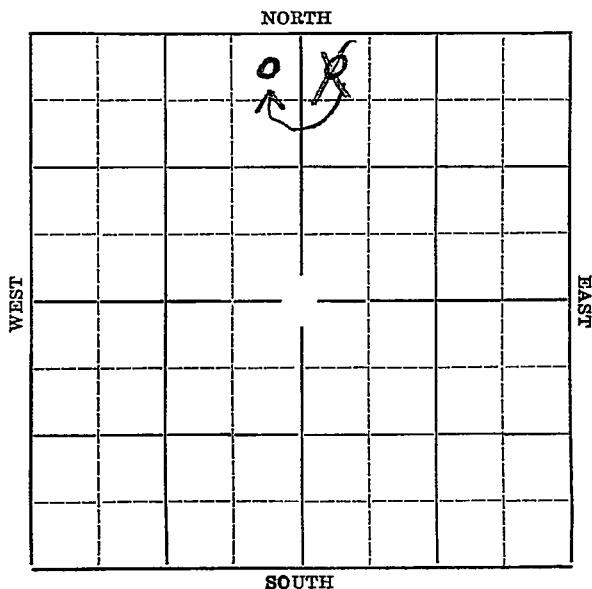
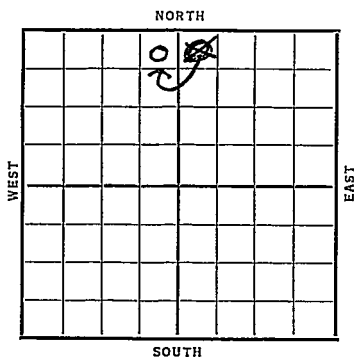


Section 27 Township 18 Range 12-WWell Number #1-SooyCompany Freeborn et al

Sec. 27 Twp. 18 R. 12WWell No. #1 Sooy FarmFreeborn et al Company330' Ft. from N. Line Ft. from S. Line330 Ft. from E. Line330' Ft. from W. Line~~1936~~

REPORT

9/23 Cellar.

10/1--10/8--10/15-- 10/22--10/29--

11/6---11/12---

11/19 Rig

11/27---12/3--

12/10 Rigging up.

12/17 200'. Shut down for pipe.

12/24---12/29--

1937

1/7 Shut down for pipe 200'.

1/14 " " " " "

1/21 " " " " "

1/28 " " " " "

2/3 T. D. 200'. D & A.

ABANDONED

KANSAS

Map No. 55 Sec. 27 Twp. 18 R. 12WWell No. 1000Freeborn & Co. Company

Contractor

SECTION PLAT

		0	

330 Ft. from N. Line

_____ Ft. from S. Line

_____ Ft. from E. Line

330 Ft. from W. Line

FIRST REPORT

Location _____

Rig up _____

Drilling and Remarks:

O & Har

RECORD

Cased _____ in., _____ ft.

Sand _____

Gas _____

Oil _____

Total Depth _____

PRODUCTION

1st 24 hrs. Nat. _____

1st 24 hrs. after shot _____

Gas _____ Cu. Ft.

Dry Hole _____

Abandoned _____

Date

SEP 23 1936

19

S. J. LEWIS Scout

Map No. 53 Sec. 27 Twp. 18 R. 12WWell No. 1000Free & Co. & Co. Company

Contractor

SECTION PLAT

		O		

280 Ft. from N. Line

_____ Ft. from S. Line

330 Ft. from E. Line

_____ Ft. from W. Line

CORRECTION

Location _____

Rig up _____

Drilling and Remarks:

Reported
NWNE.

RECORD

Cased _____ in., _____ ft.

Sand _____

Gas _____

Oil _____

Total Depth _____

PRODUCTION

1st 24 hrs. Nat. _____

1st 24 hrs. after shot _____

Gas _____ Cu. Ft.

Dry Hole _____

Abandoned _____

Date

NOV 25 1936

19

S. J. LEWIS Scout

KANSAS

Map No. 55 Sec. 27 Twp. 18 R. 12WWell No. 1000Frederick & Co. Company

Contractor

SECTION PLAT

	0		

330 Ft. from N. Line

_____ Ft. from S. Line

330 Ft. from E. Line

_____ Ft. from W. Line

ABANDONED

Location _____

Rig up _____

Drilling and Remarks:

D & H

RECORD

Cased _____ in., _____ ft.

Sand _____

Gas _____

Oil _____

Total Depth 200

PRODUCTION

1st 24 hrs. Nat. _____

1st 24 hrs. after shot _____

Gas _____ Cu. Ft.

Dry Hole _____

Abandoned _____

Date

FEB 3 1937

19

S. J. LEWIS Scout