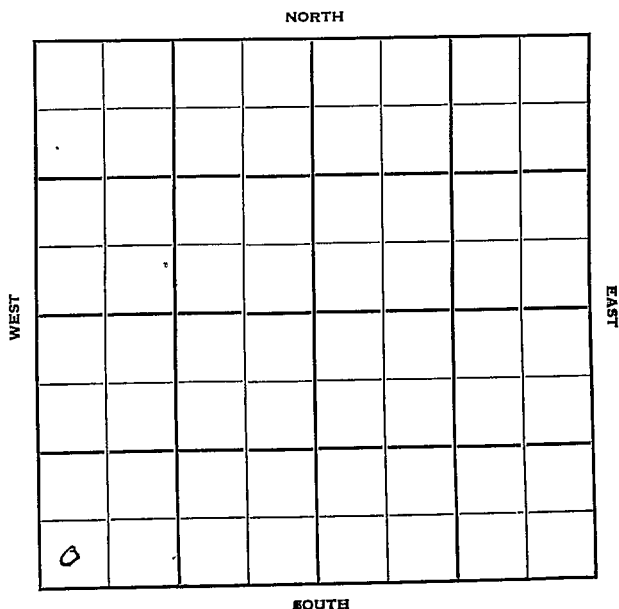


Section 3 Township 18 Range 13WWell No. #1 RiedlCompany Herndon Drlg.

Barton

KANSAS

Sec. 3 Twp. 18 R. 13W

Well No. #1 Riedl Farm

Herndon Drlg. Company

Wildcat Contractor

Ft. from N. Line


330'

Ft. from S. Line

Ft. from E. Line

330' Ft. from W. Line

SW SW SW

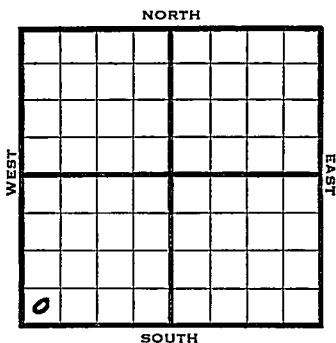

1950

Elev 1808

REPORT

8/23

Location

9/20

Spud 9-7-50

13" @ 140

Anhy 720

8" @ 730

Br lime 3064

Lans 3077

DST 3079-3115

opn 30 min rec 6' mud

Arb B324-70 TD

TD 3370

D&A

**ABANDONED**

County Barton State KansasSec. 8 (Blk. Twp.) 18 (Sur. Rge.) 13W Map No.Operator Herndon Drlg.Well No. 1 Farm RiedlElev. Location SW SW SW

|   |  |  |  |  |  |  |  |
|---|--|--|--|--|--|--|--|
|   |  |  |  |  |  |  |  |
|   |  |  |  |  |  |  |  |
| 0 |  |  |  |  |  |  |  |

330 Ft. From S Line SW330 Ft. From W Line Quarter1st. Report AUG 23 1950

Completion


Remarks

Sunray farmout

Spudding Date

Drlg. Data WildcatLocation

J. E. TYRA

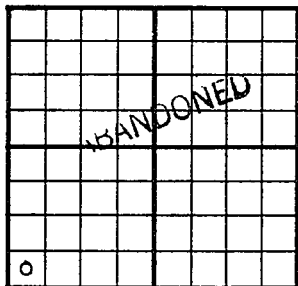County Barton State KansasSec. 3 (Blk.  
Twp.) 18 (Sur.  
Rge.) 13W Map No.Operator Herndon Drlg.Well No. 1 Farm RiedlElev. 1808 Location SW SW SW330 Ft. From S Line SW330 Ft. From W Line QuarterIst. Report ~~SEP 20 1950~~Completion SEP 20 1950

Remarks

WildcatSpudding Date 9-7-50Drlg. Data D & A TD 337013" @ 140 Anhy 720 8" @ 730Br. lime 3064 Lans. 3077 DST 3079-3115open 30 min. Rec. 6' mud Arb. 3324-70 TDD & A

J. E. TYRA