

Section 31 Township 31 Range 6-E

Well No. 4 Drury


Company E. Wakefield

Miscellaneous

NORTH

WEST

EAST

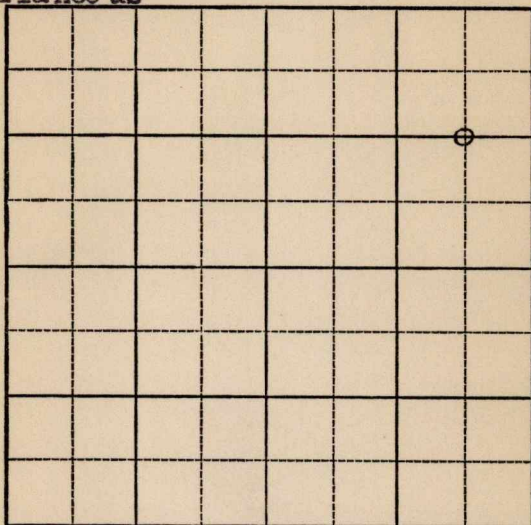

SOUTH

Sec. 31 Twp. 31 R. 6E

Well No. #4 Drury Farm

E. Wakefield Company

Misc.


1320 Ft. from N. Line

_____ Ft. from S. Line

660 Ft. from E. Line

_____ Ft. from W. Line

C E $\frac{1}{2}$ NE

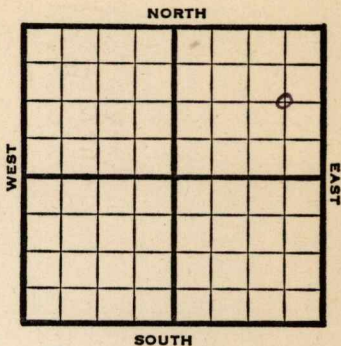

1947

Elev. 1365' REPORT

9/17 Location

9/24 8" @ 104'
Drlg. 1180'

10/1 Drlg. 2714'

10/8 **Bart 2923'**
5" @ 2920'
TD 2966'
SSO

10/15 "

10/22 "

10/29 **Bart 2923'**
TD 2988'

ABANDONED

Map No. 2 Sec. 31 Twp. 31 R. 6E

Well No. 4 Drury

E. Wakefield Company

FIRST REPORT Contractor

C $E\frac{1}{2}$ NE

SECTION PLAT

1320 Ft. from N. Line

_____ Ft. from S. Line

660 Ft. from E. Line

_____ Ft. from W. Line

| | | | |
|--|--|--|---|
| | | | |
| | | | 6 |
| | | | |
| | | | |
| | | | |

Cowley County

Location _____

Rig up _____

Drilling and Remarks:

RECORD

Cased _____ in., _____ ft.

Sand _____

Gas _____

Oil _____

Total Depth _____

PRODUCTION

1st 24 hrs. Nat. _____

1st 24 hrs. after shot _____

Gas _____ Cu. Ft.

Dry Hole _____

Abandoned _____

Date

SEP 17 1947 19

S. J. LEWIS

Scout

Map No. 2 Sec. 31 Twp. 31 R. 6E

Well No. 4 Drury

E. Wakefield Company

ABANDONED

Contractor

C $E\frac{1}{2}$ NE

E. 1/1865

SECTION PLAT

1320 Ft. from N. Line

_____ Ft. from S. Line

660 Ft. from E. Line

_____ Ft. from W. Line

| | | | |
|--|--|--|---|
| | | | |
| | | | • |
| | | | |
| | | | |
| | | | |

Cowley County

Location _____

Rig up _____

Drilling and Remarks:

Bar Y 2923

RECORD

Cased _____ in., _____ ft.

Sand _____

Gas _____

Oil _____

Total Depth 2988

PRODUCTION

1st 24 hrs. Nat. _____

1st 24 hrs. after shot _____

Gas _____ Cu. Ft.

Dry Hole _____

Abandoned _____

Date

OCT 29 1947 19

S. J. LEWIS

Scout