


Map No. 15 Sec. 6 Twp. 31 R. 6

Well No. 8 Bardwell Farm
Southern (Bardwell) Company

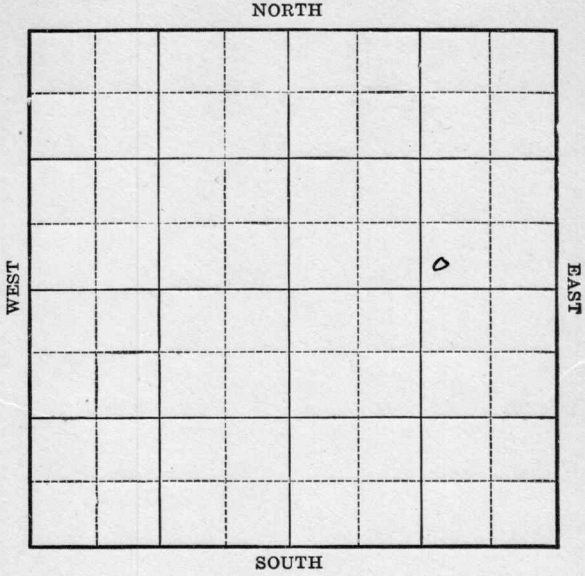

Location _____

Drilling Remarks:

Rig Up _____

Drilling Remarks:

RECORD

Cased _____ in. _____ ft.

Sand _____

Gas _____

Oil _____

Total Depth _____

PRODUCTION

1st 24 hrs. Nat. _____

1st 24 hrs. after shot _____

Gas _____ cu. ft.

Dry Hole _____

Abandoned _____

Map No. 15 Sec. 6 Twp. 31 R. 6


Well No. 8 Barwell Farm
Southern Company

_____ Ft. from N. Line

330 Ft. from S. Line

990 Ft. from E. Line

_____ Ft. from W. Line

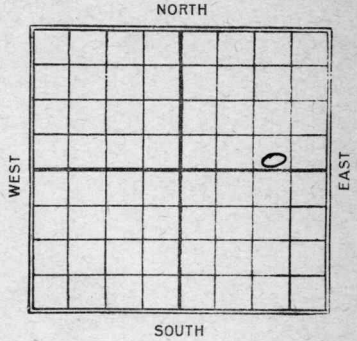

1924

REPORT

8/26
11/28

Reg up
Sample 2848-2880 Pumping
45 nat

2 **KANSAS** Map No. Sec. 6 Twp. 31 R. 6

Well No. 8 *Bardwell*

Southwestern Company

Contractor

FIRST REPORT

SECTION PLAT

----- Ft. from N. Line

330 Ft. from S. Line

990 Ft. from E. Line

----- Ft. from W. Line

			0

Location -----

Rig up *✓✓* -----

Drilling and Remarks:

RECORD

Cased ----- in., ----- ft.

Sand -----

Gas -----

Oil -----

Total Depth -----

PRODUCTION

1st 24 hrs. Nat. -----

1st 24 hrs. after shot -----

Gas ----- Cu. Ft.

Dry Hole -----

Abandoned -----

Date

AUG 26 1924

M. A. BENEAR

Scout

Map No. **KANSAS** Sec. 6 Twp. 31 R. 6^E

Well No. 8 Bardwell

Southwestern Pet Company

Contractor

COMPLETED

SECTION PLAT

----- Ft. from N. Line
330' Ft. from S. Line
990' Ft. from E. Line
 ----- Ft. from W. Line

			o

Location -----

Rig up -----

Drilling and Remarks:

*Sand 2848-2880
 Pumping 45 bbls
 Nat.*

RECORD

Cased ----- in., ----- ft.
 Sand -----
 Gas -----
 Oil -----
 Total Depth -----

PRODUCTION

1st 24 hrs. Nat. -----
 1st 24 hrs. after shot -----
 Gas ----- Cu. Ft.
 Dry Hole -----
 Abandoned -----

Date **NOV 28 1924**

M. A. BENEAR

----- 192 -----

----- Scout