


Map No. 25 Sec. 6 Twp. 31 R. 6

Well No. 1 Eastman Farm
OW Inters Company

NORTH

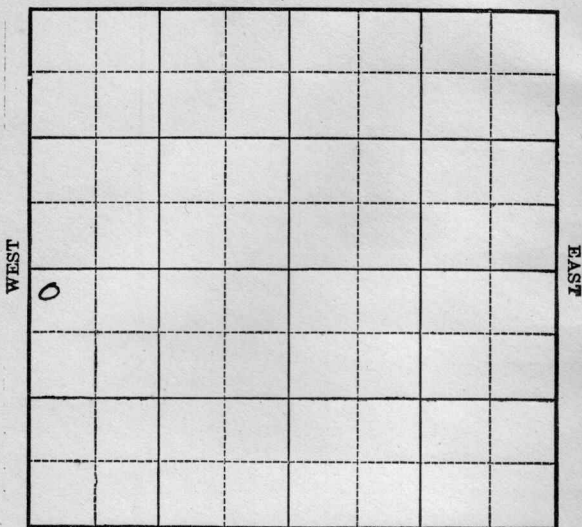

SOUTH

Location _____

Rig up _____

Drilling Remarks:

Drilling Remarks:

RECORD

PRODUCTION

Cased _____ in. _____ ft.

1st 24 hrs Nat. _____

Sand _____

1st 24 hrs. after shot _____

Gas _____

Gas _____ cu. ft.

Oil _____

Dry Hole _____

Total Depth _____

Abandoned _____

2 **KANSAS** Map No. Sec. 6 Twp. 31 R. 6

Well No. 1 *E. Estman*

C. W. Titus Company

Contractor

FIRST REPORT

SECTION PLAT

300 Ft. from N. Line

----- Ft. from S. Line

----- Ft. from E. Line

300 Ft. from W. Line

0			

Location -----

Rig up *✓✓* -----

Drilling and Remarks:

L Only 1350

RECORD

Cased ----- in., ----- ft.

Sand -----

Gas -----

Oil -----

Total Depth -----

PRODUCTION

1st 24 hrs. Nat. -----

1st 24 hrs. after shot -----

Gas ----- Cu. Ft.

Dry Hole -----

Abandoned -----

Date JUN 10 1924

M. A. BENEAR

Map No. 7 **KANSAS** Sec. 6 Twp. 31 R. 6

Well No. 1 *Cushman*

C. W. Titus Company

Contractor

ABANDONED SECTION PLAT

200 Ft. from N. Line

----- Ft. from S. Line

----- Ft. from E. Line

200 Ft. from W. Line

①			

Location -----

Rig up -----

Drilling and Remarks:

Log L. 2931
W + A 2941
missed sand

RECORD

Cased ----- in., ----- ft.

Sand -----

Gas -----

Oil -----

Total Depth -----

PRODUCTION

1st 24 hrs. Nat. -----

1st 24 hrs. after shot -----

Gas ----- Cu. Ft.

Dry Hole -----

Abandoned -----

Date

JUL 9 1924

M. A. BENEAR

192

Scout