

Barton KANSAS

Section 2 Township 18 Range 13 WWell No. #1 EveleighCompany Kantor Oil

NORTH

WEST								
								0
EAST								

SOUTH

Sec. 2 Twp. Barton 18 R. 13W

Well No. #1 Eveleigh Farm

Kantor Oil Company

Jackson & Lindsley - Cont. Contractor
Wildcat


 Ft. from N. Line

330' Ft. from S. Line

330' Ft. from E. Line

 Ft. from W. Line

SE SE SE

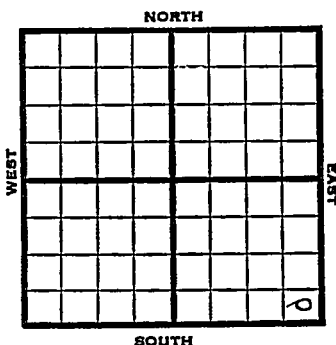

1951

Elev. 1805' REPORT

1/31

8" @ 518'

2/14

D&A TD 3356

8" @ 518' Heeb. 2988'

Br Lime 3082' KC 3093'

DST 3232-38 opn 35 min


Rec. 9' mud Cong. 3343

Arb. 3345'

DST 3346-56 TD opn 1hr Rec. 270' sw
D&A

COMPLETED

J. E. TYRA

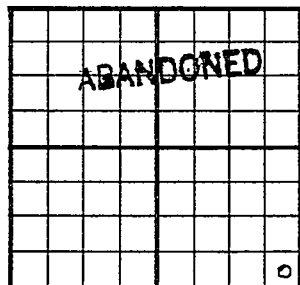County Barton State KansasSec. 2 (Blk. 18 (Sur. 13W Map No. 18)Operator Kantor OilWell No. 1 Farm EveleighElev. 1805 Location SE SE SE330 Ft. From S Line SE330 Ft. From E Line Quarter

1st. Report

Completion FEB 14 1951Remarks WildcatJackson & Lindsley - Contr

Spudding Date

Drlg. Data D & A TD 33568" @ 518 Heeb. 2988 Br. lime 3082KC 3093 DST 3232-38 open 35 min.Rec. 9' mud Cong. 3343 Arb. 3345DST 3346-56 TD open 1 hr. Rec. 270' swD & A.

J. E. TYRA