
DX 78-1

Barton KANSAS

Section 4 Township 18 Range 13 W

Well No. # 1 Johnson

Company Peters Oil

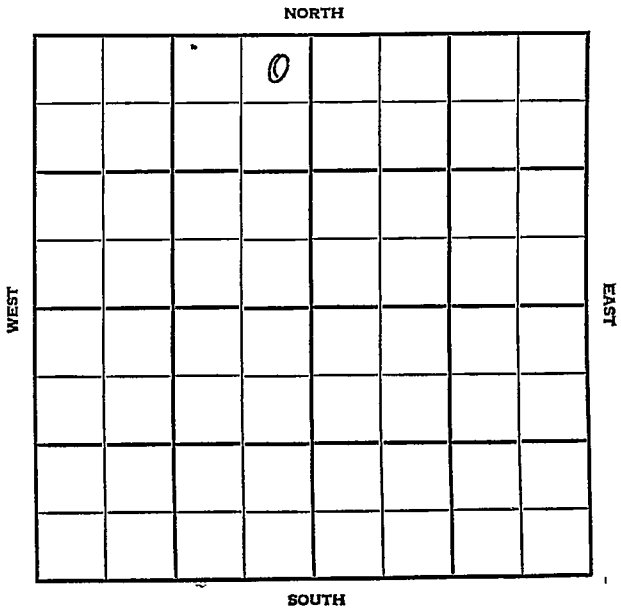

Barton KANSAS

SEC.	TWP.	R.
4	18	13W

WELL NO.

#1 Johnson FARM

COMPANY

Peters Oil

CONTRACTOR

Clark Knight


Wildcat.

330 Ft. from N. Line

Ft. from S. Line

330 Ft. from E. Line

Ft. from W. Line

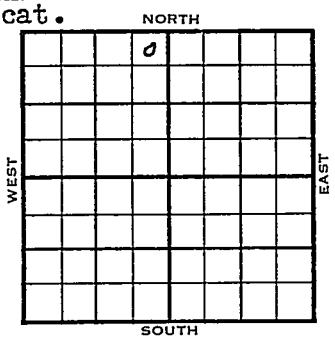

NE NE NW

Skelly DHM

1955	ELEVATION 1852'	REPORT
3/16	Spud 3-9-55 8" @ 478' Anhy 775' Drlg. 2617'	
3-23	Spud 3-9-55, D&A, TD 3362, 8" @ 478, Anhy 775, Heeb 3026, Br. Lime 3116, Lahs 3125, DST 3120-35, open 1 hr, rec 8' mud. 215#, DST 3318-30 open ½ hr. Rec 5' mud 25#, DST 3344-52, open 1 hr, Rec 7' mud. 390#, Re Arb 3348, Arb 3353, DST 3352-62 open 1 hr. Rec 7' mud 390#, TD 3362 D&A	

ABANDONED

DX-78

FORM 275 FOR SALE BY KANSAS BLUE PRINT CO


County Barton State Kansas

Sec. 4 (Blk. Twp.) 18 (Sur. Rge.) 13W Map No.

Operator Peters Oil

Well No. 1 Farm Johnson

Elev. Location NE NE NW

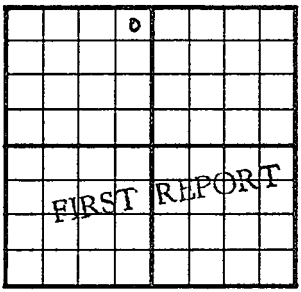

330 Ft. From N Line NW

330 Ft. From E Line Quarter

1st. Report MAR 1 6 1955

Completion

Remarks Skelly - DHM
Clark Knight - Contr.

Spudding Date 3-9-55

Drlg. Data Wildcat

8" @ 478 Anhy 775 drlg. 2617

FABEN GILSTRAP

FORM 275 FOR SALE BY KANSAS BLUE PRINT CO.


County Barton State Kansas

Sec. 4 (Blk. Twp.) 18 (Sur. Rge.) 13W Map No.

Operator Peters Oil

Well No. 1 Farm Johnson

Elev. 1852 Location NE NE NW

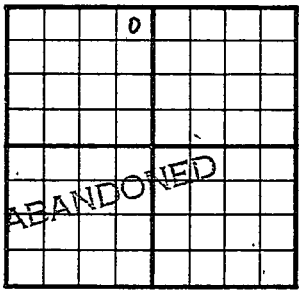

330 Ft. From N Line NW

330 Ft. From E Line Quarter

1st. Report

Completion MAR 2 3 1955

Remarks Wildcat

Clark Knight - Contr.

Spudding Date 3-9-55

Drlg. Data D & A TD 3362

8" @ 478 Anhy 775 Heeb. 3026

Br. lime 3115 Lans. 3125 DST 3120-35

open 1 hr. Rec. 8' mud 215#

DST 3318-30 open ½ hr. Rec. 5' mud

25# DST 3344-52 open 1 hr. Rec. 7' mud

390# ReArb. 3348 Arb. 3353 DST 3352-

62 open 1 hr. Rec. 7' mud 390#

TD 3362

D & A

FABEN GILSTRAP