


Section 6 Township 18 Range 13-W

Well No. #1 Johnston

Company Murfin Drlg.

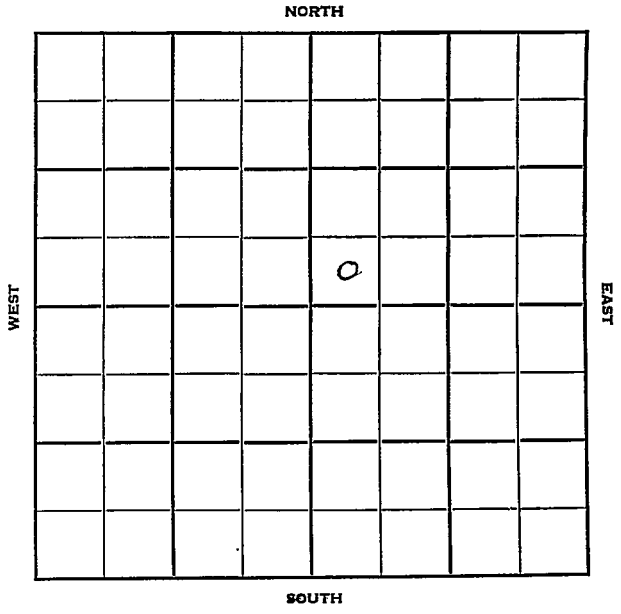

Sec. 6 Twp. 18 R. 13W

Well No. #1 Johnston ✓ Farm

Murfin Drlg. Company

Murfin Drlg. Contr. Contractor

Boyd Pool


 Ft. from N. Line

330' Ft. from S. Line

 Ft. from E. Line

330' Ft. from W. Line

SW SW NE

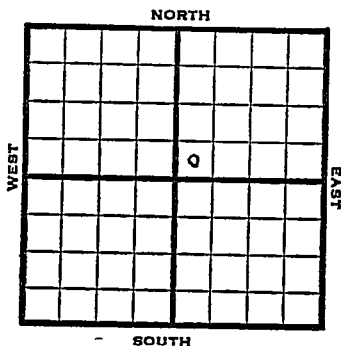

1950 Elev. 1830' REPORT

11/1 Spud 10-31-50

11/15 Spud 10-31-50

D&A TD 3355'

8" @ 158'

Anhy 775' Heeb. 3009'

Dodge 3022' KC 3101'

Arb. 3303'

DST 3304-19 Rec. 15" mud

TD 3355 D&A

ABANDONED

County Barton State Kansas

Sec. 6 (Blk. 18) (Sur. 13W) (Twp.) (Rge.) Map No.

Operator Murfin Drlg.

Well No. 1 Farm Johnston

Elev. _____ Location SW SW NE

330 Ft. From S Line NE

330 Ft. From W Line Quarter

Ist. Report NOV 1 1950

Completion _____

Remarks _____

Murfin Drlg. - Contr.

Spudding Date 10-31-50

Drlg. Data Boyd Pool

FIRST REPORT

