


*Cowley 6E*

Map No. *KANSAS* Sec. *31* Twp. *31* R. *6E*

Well No. *1-13* *Drury* Farm Company  
*Sanford et al*

NORTH

*(Drury)*

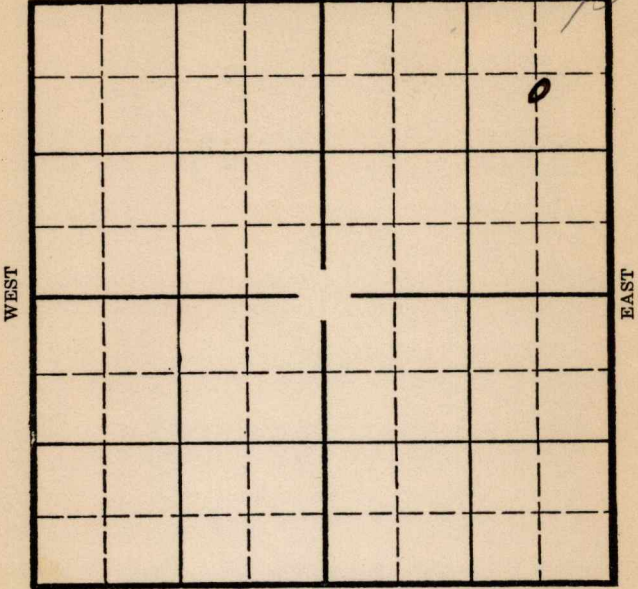

Location \_\_\_\_\_

Drilling Remarks \_\_\_\_\_

\_\_\_\_\_

\_\_\_\_\_

Rig Up \_\_\_\_\_

Drilling Remarks \_\_\_\_\_

\_\_\_\_\_

\_\_\_\_\_

\_\_\_\_\_

\_\_\_\_\_

\_\_\_\_\_

\_\_\_\_\_

\_\_\_\_\_

\_\_\_\_\_

\_\_\_\_\_

\_\_\_\_\_

RECORD

Cased \_\_\_\_\_ in. \_\_\_\_\_ ft.

Sand \_\_\_\_\_

Gas \_\_\_\_\_

Oil \_\_\_\_\_

Total Depth \_\_\_\_\_

PRODUCTION

1st 24 hrs. Nat. \_\_\_\_\_

1st 24 hrs. after shot \_\_\_\_\_

Gas \_\_\_\_\_ cu. ft. \_\_\_\_\_

Dry Hole \_\_\_\_\_


Abandoned \_\_\_\_\_

Cowley 6E

Map No.            Sec. 31 Twp. 31 R. 6E

Well No. 1-13 Burg Farm             
Sanford et al Company           

755 Ft. from N. Line  
           Ft. from S. Line  
660 Ft. from E. Line  
           Ft. from W. Line

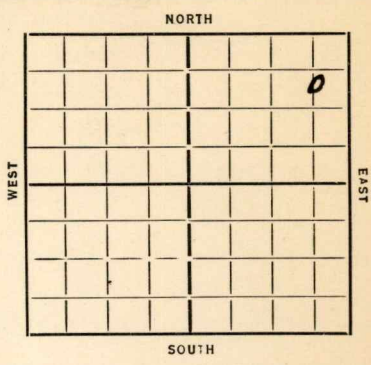

**Elev. 1375**

REPORT

Date	Notes	Pressure	Flow
6/24	Wach.		
7/3	Rgn		
7/14	Dly 325		
7/18	" 920	15"	461
7/18	Log 2012		
8/15	B.S. 2897-	5"	2900
	Pay 2920-55	500'	oil
8/22	Pay 2958	70'	oil
8/28	Shud 2897		
	TJ 2958		
	80 Bbl.		

**COMPLETED**

Map No. 21 Sec. 31 Twp. 31 R. 6E7

Well No. 1-B Dug

Somford et al Company

Contractor

SECTION PLAT

753 Ft. from N. Line

..... Ft. from S. Line

660 Ft. from E. Line

..... Ft. from W. Line

			0

FIRST REPORTS

Location.....

Rig up.....

Drilling and Remarks:

Mach

RECORD

Cased..... in., ..... ft.

Sand.....

Gas.....

Oil.....

Total Depth.....

PRODUCTION

1st 24 hrs. Nat.....

1st 24 hrs. after shot.....

Gas..... Cu. Ft.

Dry Hole.....

Abandoned.....

Date

6/26/95 192.....

ORVAL MANN SCHRECK

Scout

Map No. 2 Sec. 31 Twp. 31 R. 6E

Well No. 113 - Dury

Sanford et al Company

Contractor

SECTION PLAT

**COMPLETED**  
755 Ft. from N. Line  
..... Ft. from S. Line  
660 Ft. from E. Line  
..... Ft. from W. Line

			0

Location .....

Rig up .....

Drilling and Remarks:

80 bbls

RECORD

Cased ..... in., ..... ft.

Sand 2897

Gas .....

Oil .....

Total Depth 2958

PRODUCTION

1st 24 hrs. Nat. ....

1st 24 hrs. after shot .....

Gas ..... Cu. Ft.

Dry Hole .....

Abandoned .....

Date

8-28-35 192

ORVAL MANNSCHRECK

Scout