
KANSAS Barton

FORM 51 5M PETROL

Section 7 Township 18 Range 13W

Well No. 1 Smith

Company Branine & Herndon

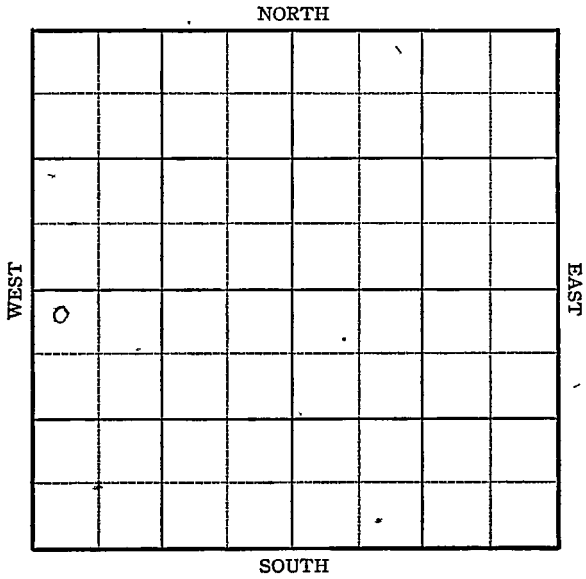

FORM 252-A
5M 3-45 PETROL

Barton County

KANSAS

Sec. 7 Twp. 18 R. 13W

Well No. #1 Smith Farm

Branine & Herndon Company

Wildcat


~~330~~ Ft. from N. Line

_____ Ft. from S. Line

_____ Ft. from E. Line

330 Ft. from W. Line

NW SW

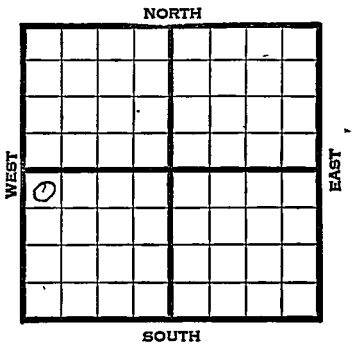


| 1945 | Elev. 1860 REPORT |
|---|---|
| 7/25 | 12" @ 140' WOC |
| 8/8 | Lans 3116<br>Arb. 3355<br>T.D. 3385'<br>ABANDONED |

FORM 26 200 BKS 2-44 PETROL

Kansas Pool Name Wildcat

KANSAS

Map No. 7 8 Sec. 7 Twp. 18 R. 13W

Well No. 1 Smith

Branine & Herndon Company

FIRST REPORT Contractor

NW SW

330 Ft. from N. Line


Ft. from S. Line

Ft. from E. Line

330 Ft. from W. Line

Barton County

SECTION PLAT

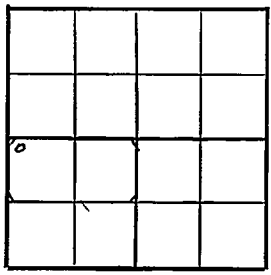

Location

Rig up

Drilling and Remarks:
12"-140 WOC

RECORD

Cased in., ft.

Sand

Gas

Oil

Total Depth

PRODUCTION

1st 24 hrs. Nat.

1st 24 hrs. after shot

Gas Cu. Ft.

Dry Hole

Abandoned

Date

JUL 25 1945 19 S. J. LEWIS Scout

FORM 26 200 BKS 1 44 PETROL

KANSAS Kansas Pool Name Wildcat

Map No. 73 Sec. 7 Twp. 18 R. 13W

Well No. 1 Smith


Branine & Herndon Company

ABANDONED Contractor

NW SW

E/1,1860

SECTION PLAT

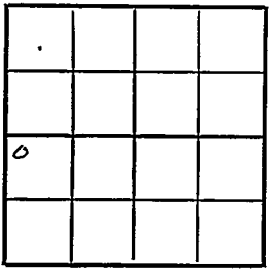

330 Ft. from N. Line

Ft. from S. Line

Ft. from E. Line

330 Ft. from W. Line

Barton County

Location

Rig up

Drilling and Remarks:

Lans 3116

Arb 3385

RECORD

Cased in., ft.

Sand

Gas

Oil

Total Depth 3385

PRODUCTION

1st 24 hrs. Nat.

1st 24 hrs. after shot

Gas Cu. Ft.

Dry Hole

Abandoned

Date

AUG 8 1945 19

S. J. LEWIS Scout