

Cowley Co

Map No. **KANSAS** Sec. *6* Twp. *31* R


Well No. *9 Eastman* Farm
Southwestern Company

1020' Ft. from N. Line

..... Ft. from S. Line

250' Ft. from E. Line

..... Ft. from W. Line

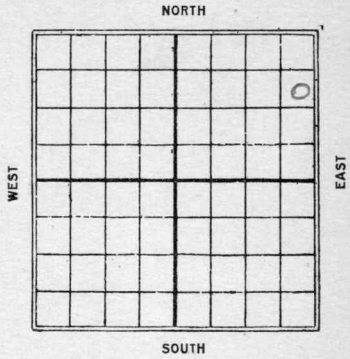

1925

Date REPORT

9/25 B. Rig

10/1 Rig

10/8 J

10/16 L Orly 310'

10/22 L 1100'

10/29

*11/19 Sand 2815-2880
8 gts 20 Bbls*

Cowley Co

Map No. **KANSAS** Sec. *6* Twp. *31* R. *6*

Well No. *9 Eastman*

Southwestern *Pet Co* Company

Contractor

FIRST REPORTS

SECTION PLAT

1070 Ft. from N. Line

Ft. from S. Line

250 Ft. from E. Line

Ft. from W. Line

			○

Location *Blog Bay*
Rig up
Drilling and Remarks:

RECORD

Cased _____ in., _____ ft.
Sand _____
Gas _____
Oil _____
Total Depth _____

PRODUCTION

1st 24 hrs. Nat. _____
1st 24 hrs. after shot _____
Gas _____ Cu. Ft.
Dry Hole _____
Abandoned _____

Date
SEP 25 1925

CHAS. L. SHERWOOD
Scout

Cowley Co

K2 KANSAS Map No. Sec. 6 Twp. 31 R. 6

Well No. 9 Eastman Southern Petroleum Co Company

Contractor

COMPLETED

SECTION PLAT

1020 Ft. from N. Line

Ft. from S. Line

250 Ft. from E. Line

Ft. from W. Line

RECORD

Location

Rig up

Drilling and Remarks:

1 AA 700

Date

NOV 19 1925

Cased in. ft.

Sand 2815-2880'

Gas

Oil

Total Depth 2880'

PRODUCTION

1st 24 hrs. Nat.

1st 24 hrs. after shot

Gas Cu. Ft.

Dry Hole

Abandoned

CHAS. L. SHERWOOD

192 Scout

8/20 bhs.