


Section 8 Township 18 Range 13 W

Well No. # 6 Biedel

Company Heathman-Seeligson

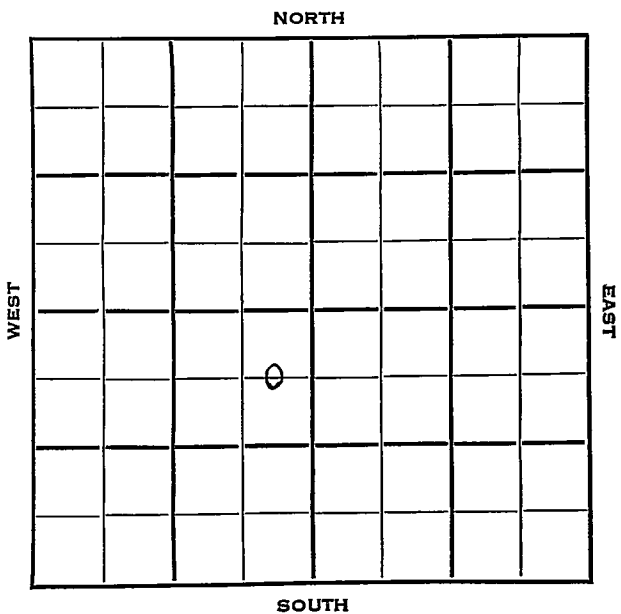

Barton KANSAS

SEC. 8 TWP. 18 R. 13W ✓

WELL NO. 6 Riedel FARM COMPANY

CONTRACTOR Heathman-Seeligson

Co. Tools

Boyd Pool


660 Ft. from N. Line

Ft. from S. Line

330 Ft. from E. Line

Ft. from W. Line

C E L NE SW

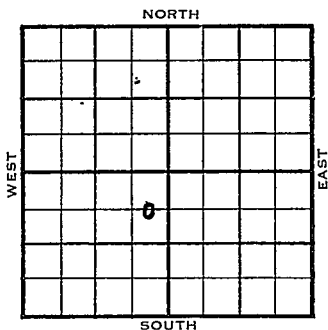

1954 ELEVATION 1822' REPORT

5/12 Cellar & Pits
 5/19 Anhy 741' 8" @ 755 w/350
 Drlg. 2640'
 5/26 Heeb 2992 Br. li 3075 Lans 3089
 DST 3208-26, 1 hr, 25' M Off
 Arb. 3311 RTD 3314 Log 5" @ 3312
 6/2 CO 3314 DD 3315 1 GOPH 250 A
 B/10 GFPH 4 hrs.
 6/9 DD 3317' frac. 3000 A No help
 PB 3315 CO 3317' B/20 GOPH 8 hrs.
 1000 A S/10 BOPH 3 hrs. FU 1800'
 oil 9 hrs.
 6/15 Spud 5-~~2112~~-54 - Oil Well
 TD 3317'
 Anhy 741'
 8" @ 755'
 Heeb 2992', Br lime 3075', Lans 3089'
 DST 3208-26', opn 1 hr., rec. 25' mud,
 Off
 Arb. 3311'
 TD 3314'
 5" @ 3312'
 CO to 3314, DD 3315, 1 goph 250A
 B/10 gfpH 4 hrs.

County Barton State KANSAS

Sec. 8 (Blk.) 18 (Sur.) 13W Map No.

Operator Heathman-Seeligson

Well No. 6 Farm Riedel

Elev. Location C E L NE SW

660 Ft. From N Line SW

330 Ft. From E Line Quarter

Ist. Report MAY 12 1954

Completion

Remarks

Co. tools

Spudding Date

Drlg. Data Boyd Pool

Cellar & pits

(Information Brought Forward)

1954
6/15

DD 3317' frac, 3000A
PB 3315', CO to 3 317
B/20 goph 8 hrs., 1000A
S/10 boph 3 hrs.
FU 1800' oil 9 hrs.
Comp. 305 bopd

COMPLETED