


Section 25 Township 20 Range 12W

Well No. 2 DeWerff "A"

Company Eldorado Ref. et al

Kowalskey Pool

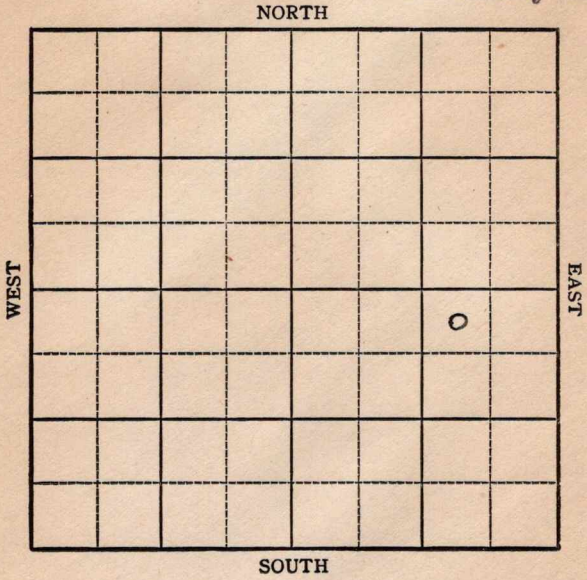

Barton

Sec. 25 **KANSAS** Twp. 20 R. 12W

Well No. #2 DeWerff "A" Farm

Eldorado Ref. et al Company  
Kowalskey Pool


330' Ft. from N. Line

\_\_\_\_\_ Ft. from S. Line

990' Ft. from E. Line

\_\_\_\_\_ Ft. from W. Line

NW NE SE

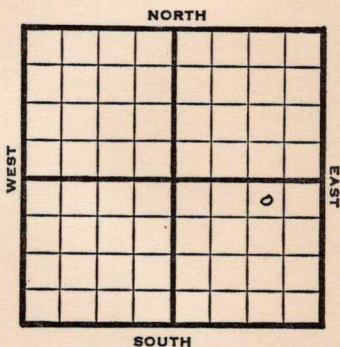

1948

**Elev. 1809'** REPORT

10/27

8" @ 249'

11/3

Drlg 3005'

11/10

**Lansing 3137'**

**Simpson 3372'**

**Arb. 3375'**

TD 3384-

5" @ 3384'

11/17

**Arb 3375'**

5" @ 3384'

TD 3434'

**ABANDONED**

Map No. \_\_\_\_\_ Sec. 25 Twp. 20 R. 12W

Well No. 2 DeWerff "A"

Eldorado Ref. etal. Company

FIRST REPORT

Contractor

NW NE SE

SECTION PLAT

330 Ft. from N. Line

\_\_\_\_\_ Ft. from S. Line

990 Ft. from E. Line

\_\_\_\_\_ Ft. from W. Line

			0

Barton County

Location \_\_\_\_\_

Rig up \_\_\_\_\_

Drilling and Remarks:

8" @ 249

RECORD

Cased \_\_\_\_\_ in., \_\_\_\_\_ ft.

Sand \_\_\_\_\_

Gas \_\_\_\_\_

Oil \_\_\_\_\_

Total Depth \_\_\_\_\_

PRODUCTION

1st 24 hrs. Nat. \_\_\_\_\_

1st 24 hrs. after shot \_\_\_\_\_

Gas \_\_\_\_\_ Cu. Ft.

Dry Hole \_\_\_\_\_

Abandoned \_\_\_\_\_

Date

OCT 27 1948 19

S. J. LEWIS Scout

Map No. 46 Sec. 25 Twp. 20 R. 12W

Well No. 2 DeWerff "A"

Eldorado Ref. etal. Company

ABANDONED Contractor

NW NE SE

*E 11/809*

SECTION PLAT

330 Ft. from N. Line

\_\_\_\_\_ Ft. from S. Line

990 Ft. from E. Line

\_\_\_\_\_ Ft. from W. Line

			0

Barton County

Location \_\_\_\_\_

Rig up \_\_\_\_\_

Drilling and Remarks:

*283375  
5' @ 3384*

RECORD

Cased \_\_\_\_\_ in., \_\_\_\_\_ ft.

Sand \_\_\_\_\_

Gas \_\_\_\_\_

Oil \_\_\_\_\_

Total Depth 3434

PRODUCTION

1st 24 hrs. Nat. \_\_\_\_\_

1st 24 hrs. after shot \_\_\_\_\_

Gas \_\_\_\_\_ Cu. Ft.

Dry Hole \_\_\_\_\_

Abandoned \_\_\_\_\_

Date

NOV 17 1948 19

S. J. LEWIS Scout