

Barton

KANSAS

Section 25 Township 20 Range 12W

Well No. #4 DeWerff "B"

Company El Dorado Ref.

NORTH

					0		

WEST

EAST

SOUTH

Sec. 25 Twp. 20 R. 12W

Well No. #4 DeWerff "B" Farm

Eldorado Ref. Company

Sterling Drlg. - Contr. Contractor

Bryant Pool


330' Ft. from N. Line

_____ Ft. from S. Line

_____ Ft. from E. Line

990' Ft. from W. Line

NE NW NE

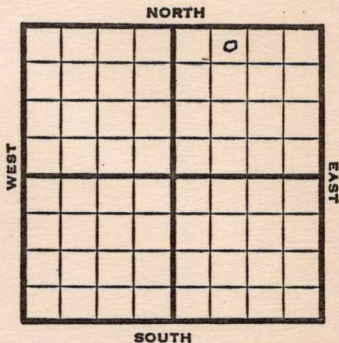

1951

Elev. 1810'

REPORT

4/4

Spud 4-1-51

8" @ 278'

Drlg. 900'

4/18

Spud 4-1-51

D & A TD 3383'

8" @ 278 **Heeb 2971'** **Br. line 3100'**

Lans. 3115' **Simp. 3354'** **Arb. 3361'**

DST 3361-67 open 1 hr. rec 8' mud

DST 3366-83' open 1 hr rec 20' mud

10' oil

D & A

ABANDONED

