


Company H H Blair

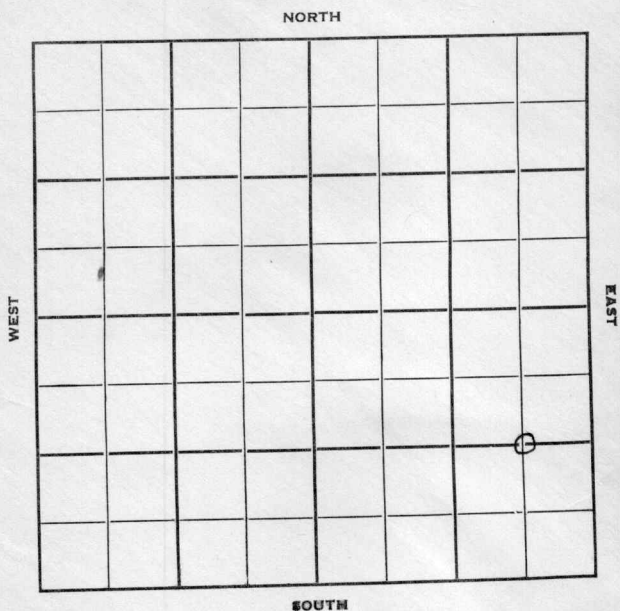

Cowley
31

KANSAS

6E ✓

Sec. 6 Twp. 31 R. 6E

Well No. #8 Eastman Farm

H. H. Blair Company

Watson - Contr. Contractor
Eastman Pool


Ft. from N. Line

1320' Ft. from S. Line

660' Ft. from E. Line

Ft. from W. Line

C E $\frac{1}{2}$ SE

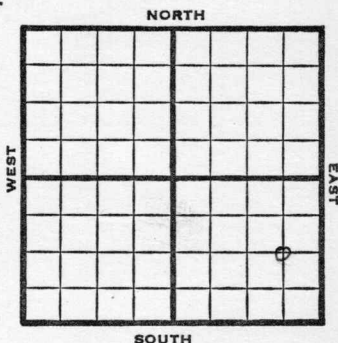

1950

Elev 1336

REPORT


10/18

Spud 10-11-50
8-5/8" @ 82'
Drlg. 1830'

11/1

8 5/8" @ 82
5" @ 2795
TD 2849
Bart 2821
SO 2840-49
Comp 18 bopd
Completed


COMPLETED

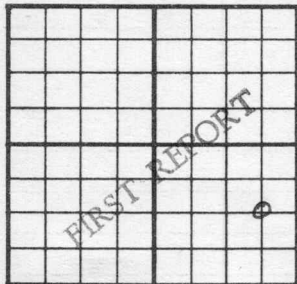County Cowley State KansasSec. 6 (Blk.) 31 (Sur.) 6E Map No.Operator H. H. BlairWell No. 8 Farm EastmanElev. Location C E $\frac{1}{2}$ SE1320 Ft. From S Line SE660 Ft. From E Line Quarter1st. Report OCT 18 1950

Completion

Remarks old wells pluggedWatson - Contr.Spudding Date 10-11-50Drlg. Data Eastman Pool8 5/8" @ 82 drlg. 1830

J. E. TYRA

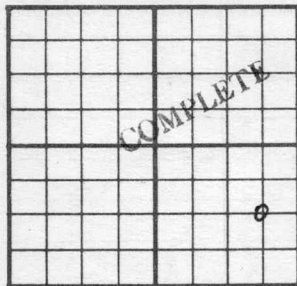County Cowley State KansasSec. 6 (Blk.) 31 (Sur.) 6E Map No.Operator H. H. BlairWell No. 8 Farm EastmanElev. 1336 Location C E $\frac{1}{2}$ SE1320 Ft. From S Line SE660 Ft. From E Line Quarter

1st. Report

Completion NOV 1 1950Remarks Eastman PoolWatson - Contr.Spudding Date 10-11-50Drlg. Data Oil well TD 28498 5/8" @ 82 5" @ 2795 TD 2849Bart. 2821 SQ 2840-49Comp. 18 bopd

J. E. TYRA