FORM 51 10M 7-48 PETROL


KANSAS Barton

Section 25 Township 20 Range 12W

Well No. 1 Jackson

Company Texas

Kowalsky Pool

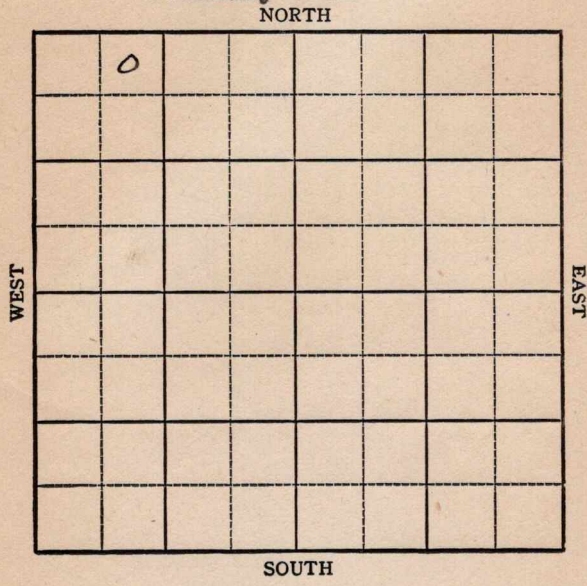

FORM 252-A
5M 10-48 PETROL

KANSAS Barton

Sec. 25 Twp. 20 R. 12W

Well No. 1 Jackson (L.M.) Farm

Texas Company
Kowalsky Pool


330 Ft. from N. Line

_____ Ft. from S. Line

_____ Ft. from E. Line

990 Ft. from W. Line

NE NW NW

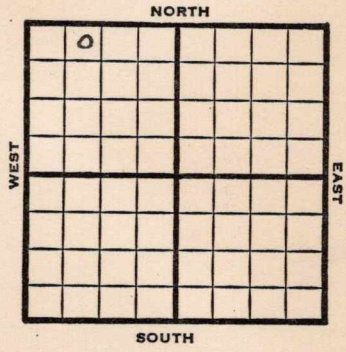

1948	REPORT
	Elev. 1811'
11/17	Location
11/23	"
11/ 30	8"@ 593' Drlg2040'
12/6	Lansing 3107' Arbuckle 3335' TD 3338' 5" @ 3337'
12/15	TD 3351' 3000 acid
12/22	Arb 3335' 5" @ 3337' 300 acid Pump 480 oil Pot. Gr. 40.9° TD 3351'
	COMPLETED

Form 26 200 Bks. 9-48 Petrol

Kansas

Kowalsky Pool

Map No. _____ Sec. 25 Twp. 20 R. 12W


Well No. 1 Jackson

Texas Company

FIRST REPORT Contractor

NE NW NW

SECTION PLAT

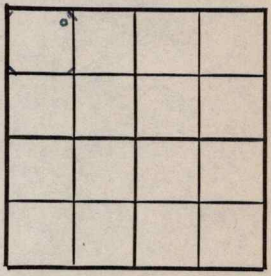

330 Ft. from N. Line

_____ Ft. from S. Line

_____ Ft. from E. Line

990 Ft. from W. Line

Barton County

Location _____

Rig up _____

Drilling and Remarks:

RECORD

Cased _____ in., _____ ft.

Sand _____

Gas _____

Oil _____

Total Depth _____

PRODUCTION

1st 24 hrs. Nat. _____

1st 24 hrs. after shot _____

Gas _____ Cu. Ft.

Dry Hole _____

Abandoned _____

Date

NOV 17 1948 19

S. J. LEWIS Scout

Form 26 200 Bks. 9-48 Petrol

Kansas

Kowalsky Pool

Map No. 46 Sec. 25 Twp. 20 R. 12W

Well No. 1 Jackson


Texas Company

COMPLETE Contractor

NE NW NW

E.1.871

SECTION PLAT

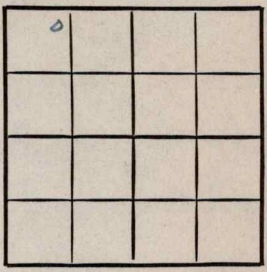

330 Ft. from N. Line

____ Ft. from S. Line

____ Ft. from E. Line

990 Ft. from W. Line

Barton County

Location

Rig up

Drilling and Remarks:

Rec 3335

5" @ 3337

350 sand

Pump 48 bbls oil

48 E.G.

RECORD

Cased ____ in., ____ ft.

Sand

Gas

Oil

Total Depth 3357

PRODUCTION

1st 24 hrs. Nat.

1st 24 hrs. after shot

Gas ____ Cu. Ft.

Dry Hole

Abandoned

Date

DEC 22 1948

19 S. J. LEWIS Scout