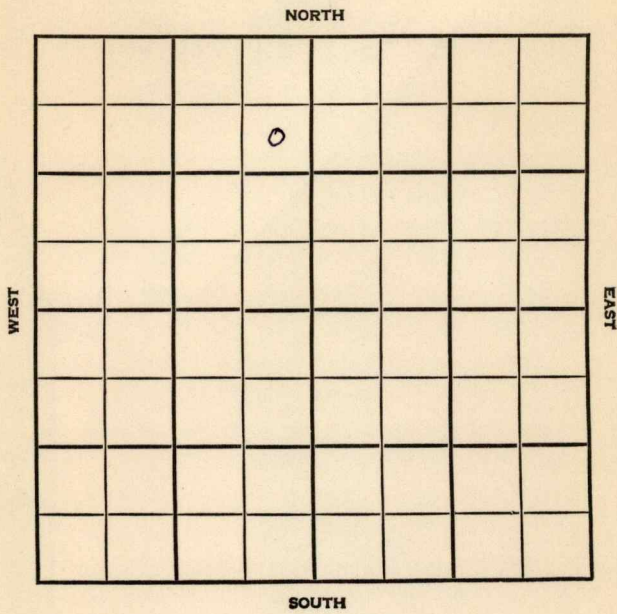


Section 31 Township 31S Range 6EWell No. 1 McMinnCompany Art Holliday

Cowley

KANSAS

SEC.	TWP.	R.
31	31 S	6 E

WELL NO.

1 McMin

FARM

COMPANY

Art Holliday

CONTRACTOR

H & M Drlg.


Wildcat

_____ Ft. from N. Line

_____ Ft. from S. Line

_____ Ft. from E. Line

_____ Ft. from W. Line

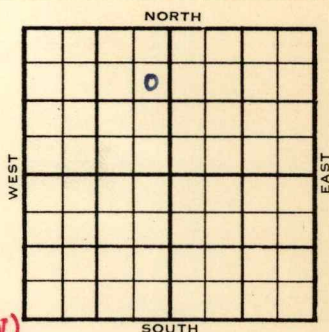

SE NE NW

SD-X -OFFSET (DS -E/2 NW)

	ELEVATION	REPORT
1955	1389	
7/13	MIRT	
7/22	Spud 7/13-55, 8 5/8" @125/75, Layton 2285, DST 2287-95, open 1 hr. rec. 19' mud, 1' ocm, 0/20", KC 2404, Oswego 2708 Drlg. 2895	
7/28	DST 2944-96 open 1 1/2 hr, rec 650' gas, 75' gcm 150' com, 30' sli. salty gcm 795/30", 5 1/2" @ 3035	
8/4	Nor report	
8/11	No Report	
8-25	8/ 2957-59, sq. to reperf.	
8/31	Comm 7-13-55	
	Layton 2285	
	KC 2404	
	BKC Oswego 2708	
	Ce Bart 2938	
	TD 3036	
	8 5/8" @ 125/75 DST 2287-95 open 1 hr Rec 19' mud 1' ocm 0/20"	
	DST 2944-96 open 1 1/2 hr Rec 650' gas 75' gcm 150' ocm 30' salty gcm 795/30" 5 1/2" @ 3035	
	8/2957/59 48/2963-75 frac	
	60 bopd 25% wtr.	
	Comp 25 bopd 25% wtr.	

Elev.

Two.

318

Res.

6E

Farm Name McMinn

No. 1

LSE

No

Sec

7.

५

County Cowley Elev. 1389
 Sec. 31 Twp. 31 Rge. 6E
 Company Art Holliday
 Farm Name McMinn No. 1

TOPS	DEPTH	LOG	DATUM	Loc. in Sec.
Anh.				SE NE NW
TP.				
H.				
Tr.				
Dg.				
BL.				
L. <u>ayton</u>	<u>2285</u>		<u>896</u>	Geol.
K.C.	<u>2404</u>		<u>1065</u>	Contr.
B.K.C. <u>Lawyer</u>	<u>2708</u>		<u>1319</u>	H & M Drlg.
Ce. <u>Bart</u>	<u>2938</u>		<u>1549</u>	Pool
C.				Wildcat
M.				
M.				
K.				
Mz.				
Mq.				
V.				
S.				
S.				
A.				
R.				
PE.				
G.				
T.D.	<u>3036</u>			

Date Comm. 7-13-55 AUG 31 1955
8 5/8" @ 125/75 DST 2287-95 open 1 hr.
Rec. 19' mud 1' ocm 0/20"
DST 2914-96 open 1 1/2 hr. Rec. 650' gas.
75' gcm 150' ocm 30' salty gcm
795/30" 5 1/2" @ 3035 8/ 2957-59
148/2963-75 frac 60 bopd 25% wtr.
Comp. 25 bopd 25% wtr.