
FORM 51 25M 8-50 WESTERN Barton KANSAS

Section 25 Township 20 Range 12W

Well No. #4 Jackson

Company Lee Drlg.

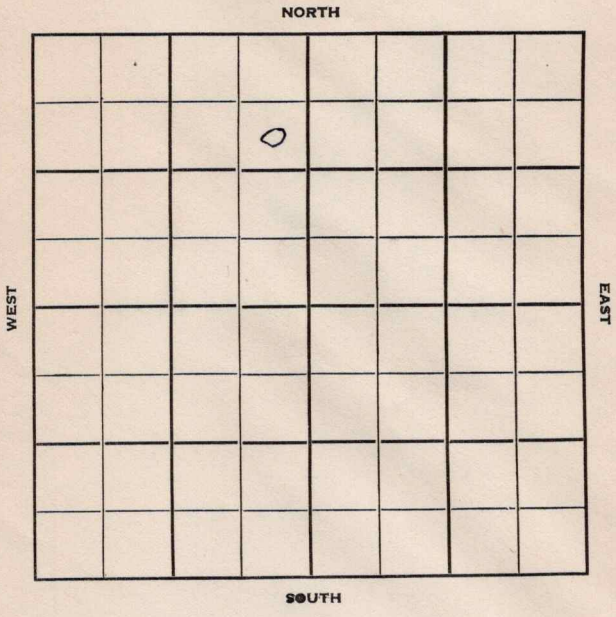

FORM 252-B
10M 8-51 TPCO.

Barton KANSAS ✓

Sec. 25 Twp. 20 R. 12 W

Well No. # 4 Jackson Farm

Lee Drlg. Company

Iron Drlg. Contractor


990 Ft. from N. Line

Ft. from S. Line

330 Ft. from E. Line

Ft. from W. Line

SE NE NW

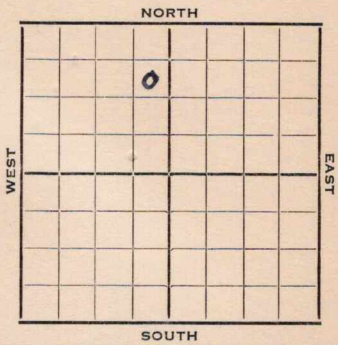

1952	Elev. 1810' REPORT
7/23	Location
7/30	8" @ 250' Heeb. 2972 Drlg. 2983'
8/6	Br Li 3101 Lans. 3115 Arb. 3352 RTD 3366 5" @ 3355 CO 3366 SO DD 3369 5 galoph 500 A
8/13	NR
8/20	"
8/27	"
9/3	"
9/10	"
9/17	"
9/24	"
10/1	"
10/8	"
10/15	"
10/22	"
10/29	"
11/5	"

OVER

743594

1952
11/12 Spud 7-22-52
Oil Well
TD 3369'
8" @ 250
Heeb 2972, Br. lime 3101, Lans
3115, Arb. 3352,
TD 3366
5" @ 3355, CO to 3366
DD 3369, 5 goph 500A
S/1 boph, 1000A, S/2 boph
P/20 bopd, dec. to 2 bopd 10 bw
Comp.

COMPLETED

FORM 275 FOR SALE BY KANSAS BLUE PRINT CO.


County Barton State Kansas

Sec. 25 (Blk. Twp.) 20 (Sur. Rge.) 12W Map No.

Operator Lee Drlg.

Well No. 4 Farm Jackson

Elev. Location SE NE NW

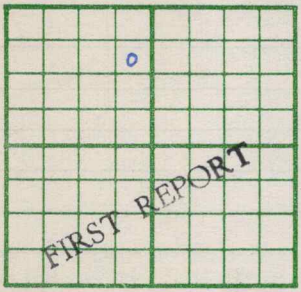

990 Ft. From N Line NW

330 Ft. From E Line Quarter

1st. Report JUL 23 1952

Completion

Remarks

Iron Drlg. - Contr.

Spudding Date

Drlg. Data

Location

J. G. McGEHEE

FORM 275 FOR SALE BY KANSAS BLUE PRINT CO.


County Barton State Kansas

Sec. 25 (Blk. Twp.) 20 (Sur. Rge.) 12W Map No.

Operator Lee Drlg.

Well No. 4 Farm Jackson

Elev. 1810 Location SE NE NW

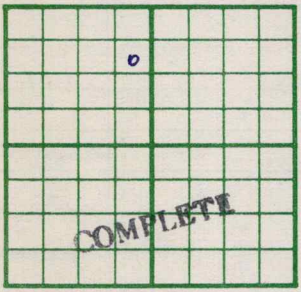

990 Ft. From N Line NW

330 Ft. From E Line Quarter

1st. Report

Completion NOV 12 1952

Remarks

Iron Drlg. - Contr.

Spudding Date 7-22-52

Drlg. Data Oil well TD 3369

8" @ 250 Heeb. 2972 Br. lime 3101

Lans. 3115 Arb. 3352 TD 3366 5" @ 3355

CO to 3366 DD 3369 5 goph 500 A

S/ 1 boph 1000 A S/ 2 boph

P/ 20 bopd dec. to 2 bopd 10 bw

Comp.

J. G. McGEHEE