


Section 32 Township 31 Range 6E

Well No. 2 Drury

Company A. M. Landon

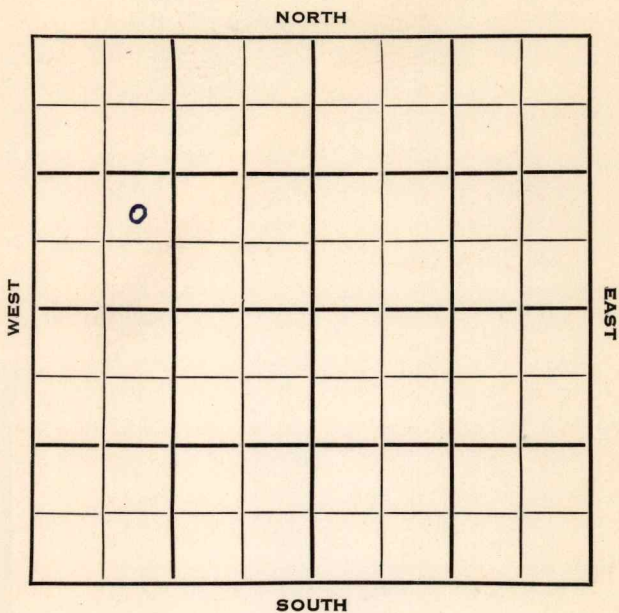


SEC.	TWP.	R.
32	31	6E

WELL NO. **2 Drury** FARM

COMPANY **A. M. Landon**

CONTRACTOR **Sunflower Drlg. Burden Pool**

\_\_\_\_\_ Ft. from N. Line  
 990 \_\_\_\_\_ Ft. from S. Line  
 \_\_\_\_\_ Ft. from E. Line  
 990 \_\_\_\_\_ Ft. from W. Line

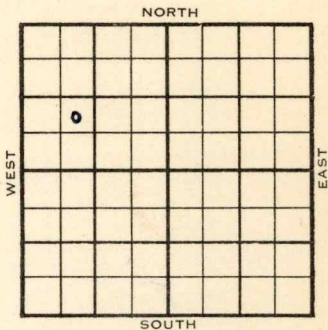

NE SW NW

1954	ELEVATION	REPORT
------	-----------	--------

4/7

Spud 4-2-54  
 8" @ 127'  
 Lans 1995'  
 Core 2051-76

6/9

Spudding 4-2-54  
 Oil well  
 TD 2320  
 8" @ 127  
 Lans. 1995 Layton 2248  
 TD 2320  
 5" @ 2320  
 5" @ 2320 CO to 2289 10/2276 79  
 wtr. PB 2269 perf/ 2261-64  
 Hydro. Comp 5 bopd. wtr.

**COMPLETED**



