


Section 32 Township 31 Range 6 E

Well No. # 8 Gulick

Company Texas Company

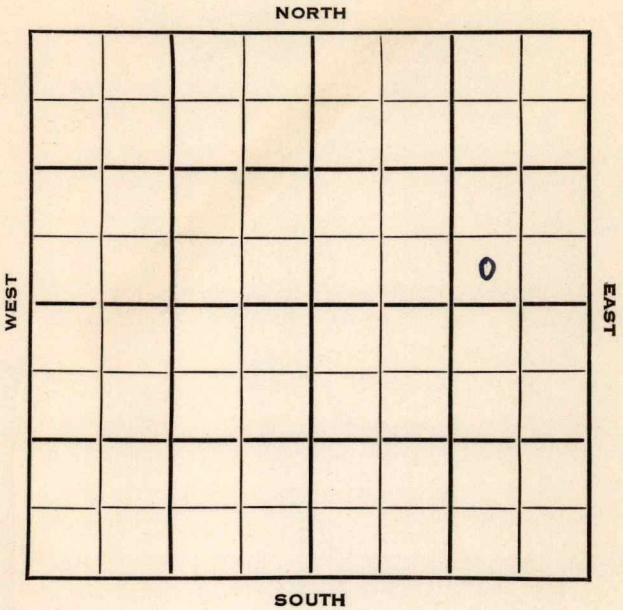

Sec. 32 Twp. 31 R. 6 E

Well No. # 8 Gulick Farm

Texas Company Company

Cappitt Contractor

E. Burden Pool


Ft. from N. Line

330 Ft. from S. Line

990 Ft. from E. Line

Ft. from W. Line

SW SE NE

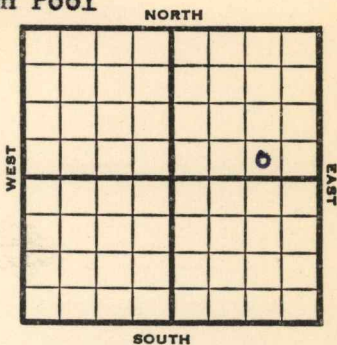

1953 Elev. 1359' REPORT

8/5 Spud 8-1-53  
10-3/4" @ 126  
Drlg. 1328'

8/26 Spud 8-1-53  
Oil Well  
TD 2293'  
10-3/4" @ 126'  
Stal. 1853', Lansl892', KC 2181', Lay-  
ton 2184'  
TD 2293'  
7" @ 2293'  
CO to 2263'  
19/ 2250-56 1 boph 20 gw  
sd-oil-frac F/ 72 bo 1 1/2 hr.  
F/ 67 bo 2 hr. F/ 67 bo 2 hr.  
Comp. 25 bopd.

COMPLETED

County Cowley State Kansas

Sec. 32 (Blk.) 31 (Sur.) 6E Map No.

Operator Texas Company

Well No. 8 Farm Gulick

Elev. 1359 Location SW SE NE

|  |  |  |  |  |  |
|--|--|--|--|--|--|
|  |  |  |  |  |  |
|  |  |  |  |  |  |
330 Ft. From S Line NE

990 Ft. From E Line Quarter

1st. Report AUG 5 1953

Completion \_\_\_\_\_

Remarks \_\_\_\_\_

Capitt - Contr.

Spudding Date 8-1-53

Drlg. Data E. Burden Pool

10 3/4" @ 126 drlg. 1328

