


Section 32 Township 31 Range 6 E

Well No. # 15 Gulick

Company Texas Company

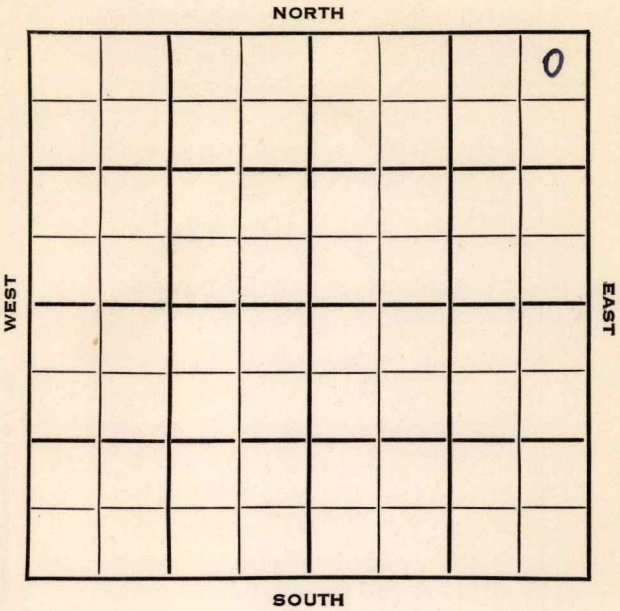

Cowley

SEC. 32	TWP. 31	R. 6E	KANSAS ✓
------------	------------	----------	--------------------

WELL NO. #15 Gulick FARM

COMPANY Texas Company

CONTRACTOR Capitt Drlg.


E. Burden Pool

330 Ft. from N. Line

Ft. from S. Line

330 Ft. from E. Line

Ft. from W. Line

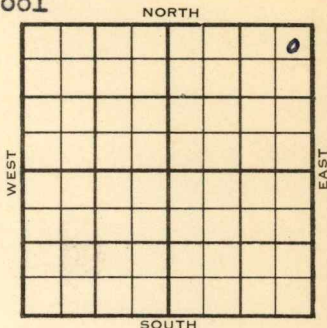

NE NE NE

1953	ELEVATION 1351'	REPORT
------	---------------------------	--------

11/24 M I R

1954
1/6

Spud 11-24-53
Oil Well
TD 2285'
10-3/4" @ 125'
KC 2184', L^{ay}ton 2189'
TD 2285'
7" @ 2284'
CO to 2254
13/2241-45
S/1 1/2 bwph SSO
A-frac
Stal. 1819', L^{ans} 1871'
Comp. 7 bopd 21 wtr.

COMPLETED

