


Section 32 Township 31 Range 6 EWell No. # 11 GulickCompany Texas Company

Cowley

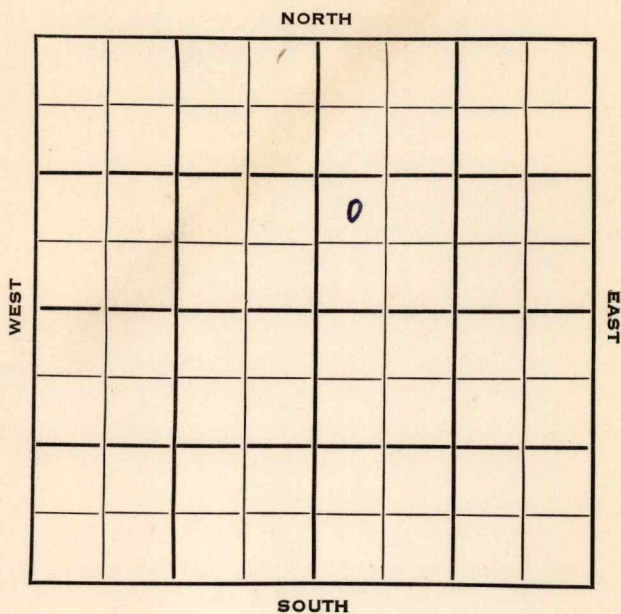

|      |      |    |
|------|------|----|
| SEC. | TWP. | R. |
| 32   | 31   | 6E |


KANSAS

WELL NO. #11 Gulick FARM

COMPANY Texas Company

CONTRACTOR Capitt Drlg.  
E. Burden Pool

\_\_\_\_\_ Ft. from N. Line  
690 \_\_\_\_\_ Ft. from S. Line  
\_\_\_\_\_ Ft. from E. Line  
330 \_\_\_\_\_ Ft. from W. Line

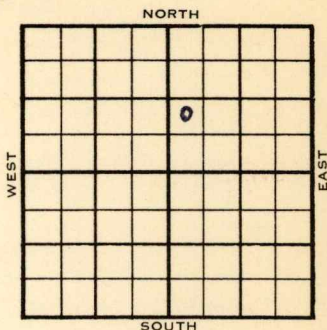

NW SW NE

| 1953 | ELEVATION   | REPORT |
|------|---|--------|
|      | 1380'   |        |
| 9/9  | Spud 9-6-53<br>10" @ 127'<br>Drlg 795'   |        |
| 9/30 | Spud 9-6-53<br>Oil Well<br>TD 2323'<br>10" @ 127'<br>Stal. 1859, Lans 1917, KC 2208, Layton 2211'<br>TD 2323'<br>7" @ 2321'<br>CO to 2293'<br>19/ 2284-90 A-frac<br>S & F/ 70 bo 56 bw 9 hr.<br>F/ 40 bo 14 bw 6 hr. F/ 78 bo 33 bw 8 hr.<br>Comp 25 bopd 30% wtr.<br>8 hr.<br>Comp 25 bopd 30% wtr. |        |

COMPLETED

County

State

Sec.

32

(Blk.)  
(Twp.)

31

(Sur.)  
(Rge.)

6E

Operator

Well No.

11

Farm

Elev.

### Location

NW SW NE

0

FIRST REPORT

990 Ft. From

**S Line**

NE

330 Ft. From

### W Line

Quarter

### 1st. Report

SEP

9

3

### Completion

Remarks

Capitt Drlg. - Contr.

Spudding Date

9-6-53

Drlg. Data

## E. Burden Pool

10<sup>th</sup> 127

drlg. 795

J. G. McGEHEE