


Section 32 Township 31 Range 6 E

Well No. # 13 Gulick

Company Texas Company

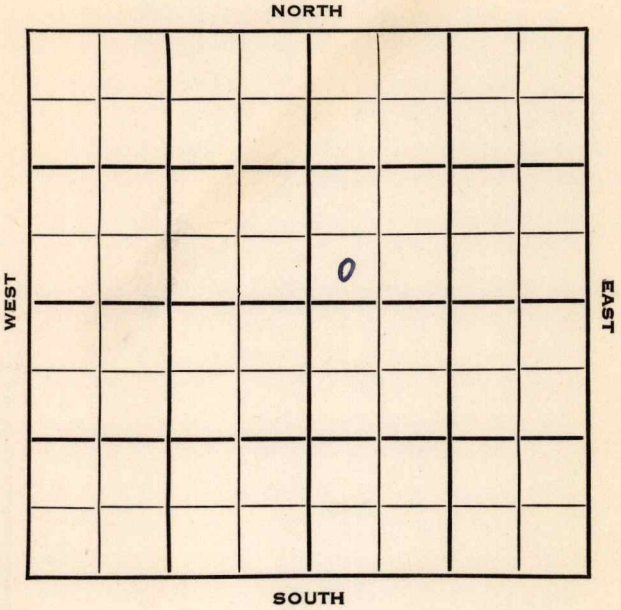

Cowley

KANSAS

SEC.	TWP.	R.
32	31	6 E

WELL NO.

13 Gulick

FARM

COMPANY

Texas Company

CONTRACTOR

Capitt Drlg.

E. Burden Pool


Ft. from N. Line

330 Ft. from S. Line

Ft. from E. Line

330 Ft. from W. Line

SW SW NE

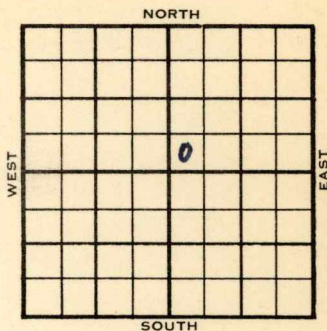

	ELEVATION	REPORT
1953	1372'	

10/14 Spud 10-11-53
10" @ 126
Drlg. 725'

11/11 Spud 10-11-53
Oil Well
TD 2320'
10" @ 126'
Elgin 1430', Doug 1636', Stal. 1861',
KC 2210', Layton 2214'
TD 2320'
7" @ 2315
CO to 2280'
19/2274-80, 6 gwph
sd-oil $\frac{1}{2}$ frac
PB 2268
38/2252-64, B/17 go 12 gwph
sd-oil-frac
S/5-3/4 bo 3 $\frac{1}{2}$ bwph
CO to 2281
S/13 bo 21 bwph
Comp. 73 bopd 95 bw

COMPLETED

