

Cowley

KANSAS


SEC.	TWP.	R.
32	31	6E ✓

WELL NO. #5 O.F. Lawson FARM

COMPANY Texas Company

CONTRACTOR

990 Ft. from N. Line
 _____ Ft. from S. Line
 _____ Ft. from E. Line
 990 Ft. from W. Line

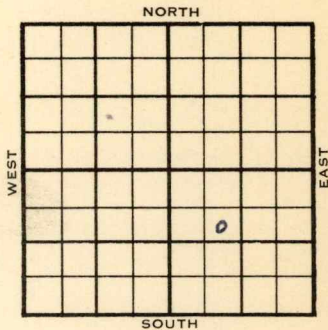

SE NW SE

1954	ELEVATION 1350'	REPORT
------	--------------------	--------

2/17

Location

3/24

Spud 2-16-54
 Oil Well
 TD 2300'
 10" @ 123'
 KC 2196', Layton 2230',
 TD 2300'
 7" @ 2299'
 CO to 2269'
 12/ 2236-40 sd-frac S & F/ 104 bo
 40 bw 18 hr.
 Comp 38 bopd 102 bw.

COMPLETED

