


Section 32 Township 31 Range 6E

Well No. 6 O. F. Lawson

Company Texas Company

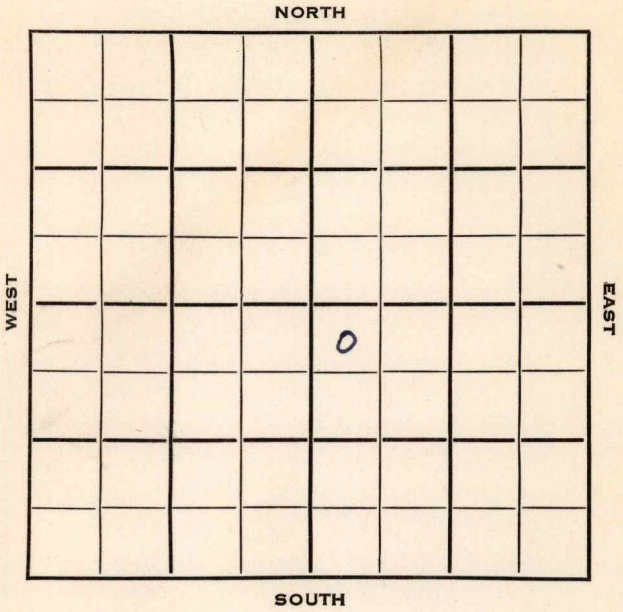

Cowley KANSAS

SEC.	TWP.	R.
32	31	6E ✓

WELL NO. 6 O. F. Lawson FARM

COMPANY Texas Company

CONTRACTOR Capitt Drlg.


E. Burden Pool

330 Ft. from N. Line

\_\_\_\_\_ Ft. from S. Line

\_\_\_\_\_ Ft. from E. Line

330 Ft. from W. Line

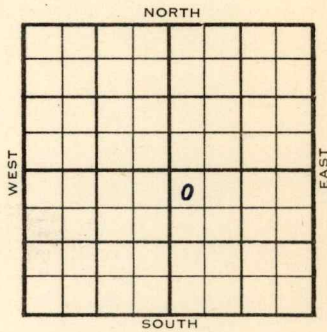

NW NW SE

1954	ELEVATION	REPORT
	1365'	

4/7 Spud 4-5-54  
Drlg. 110'

4/21 Spud 4-5-54  
D & A  
TD 2335'  
10-3/4" @ 122'  
Stal. 1870', Lans 1922', KC 2205'  
Layton 2222'  
TD 2335'  
D & A

**ABANDONED**



