

KANAS

FORM 51 25M 3-49 PETROL

Barton

Section 26 Township 20 Range 12W

Well No. 4 Bryant "C"


Company Alpine Oil & Royalty

Bryant

NORTH

WEST

EAST

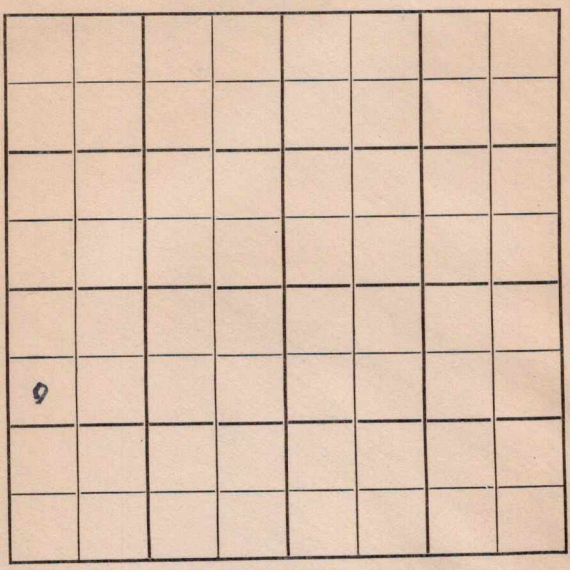

SOUTH

Barton

KANSAS ✓

Sec. 26 Twp. 20 R. 12W

Well No. #4 Bryant "C" Farm _____

Alpine Oil & Royalty Company

Bryant Pool


990' Ft. from N. Line

_____ Ft. from S. Line

_____ Ft. from E. Line

330' Ft. from W. Line

SW NW SW

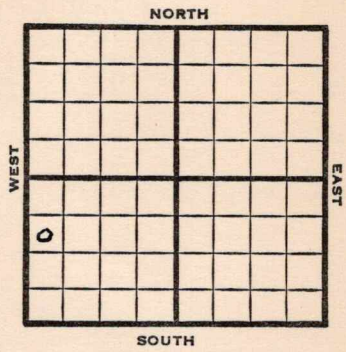

1949 **Elev 1831'** REPORT

8/31 Surface Hole
 9/7 8" @ 260'
Lansing 3147'
 Drlg. 3253'
 9/14 **Arb. 3384'**
 5" @ 3385'
 TD 3420'
 2700' oil 2 hrs.
 9/21 "
 9/28 "
 10/5 "
 10/12 "
 10/19 TD 3420'
Arb. 3384'
 5" @ 3385'
 Pump 485 Oil / 2% W Pot
 41⁶ Gr.
 Comp

COMPLETED

Map No. _____ Sec. 26 Twp. 20 R. 12W

Well No. 4 Bryant "C"

Alpine Oil & Royalty Company

Contractor _____

SW NW SW

FIRST SECTION PLAT

990 Ft. from N. Line

_____ Ft. from S. Line

_____ Ft. from E. Line

330 Ft. from W. Line

Barton County

Location _____

Rig up _____

Drilling and Remarks: _____

surface hole

RECORD

Cased _____ in., _____ ft.

Sand _____

Gas _____

Oil _____

Total Depth _____

PRODUCTION

1st 24 hrs. Nat. _____

1st 24 hrs. after shot _____

Gas _____ Cu. Ft.

Dry Hole _____

Abandoned _____

Date

AUG 31 1949 19

S. J. LEWIS Scout

Kansas

Map No. _____ Sec. 26 Twp. 20 R. 12W

Well No. 4 Bryant "C"

Alpine Oil & Royalty Company

COMPLETE

Contractor

SW NW SW

E. H. B. I.
SECTION PLAT

990 Ft. from N. Line

_____ Ft. from S. Line

_____ Ft. from E. Line

330 Ft. from W. Line

Barton County

Location _____

Rig up _____

Drilling and Remarks:

Cor 83384

5103385

Pump 480 oil + 290

P.T.

415

RECORD

Cased _____ in., _____ ft.

Sand _____

Gas _____

Oil _____

Total Depth *3420*

PRODUCTION

1st 24 hrs. Nat. _____

1st 24 hrs. after shot _____

Gas _____ Cu. Ft.

Dry Hole _____

Abandoned _____

Date

OCT 19 1949

19

S. J. LEWIS Scout