


Section 26 Township 20 Range 12-W

Well No. #5 Bryant "C"

Company Alpine Oil

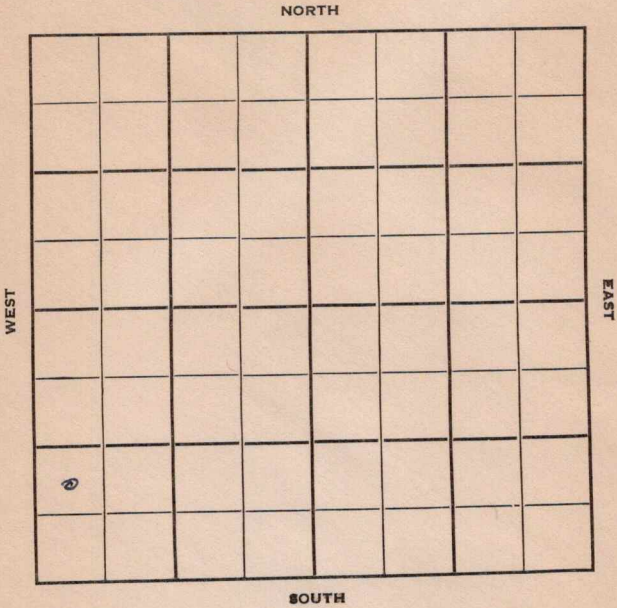

Barton **KANSAS**

Sec. 26 Twp. 20 R. 12W

Well No. #5 Bryant "C" Farm

Alpine Oil Company

Contractor


 Ft. from N. Line

990' Ft. from S. Line

 Ft. from E. Line

330' Ft. from W. Line

NW SW SW

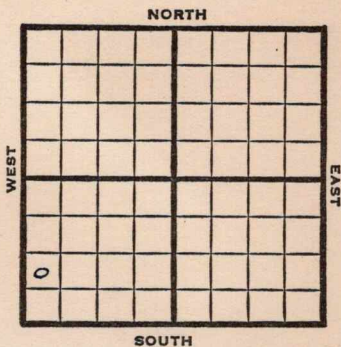

1950

Elev 1827

REPORT

4/5

RUR

5/10

TD 3410

8" @ 258

Lans 3142

Anb 3376

5" @ 3377

97 BOPD

Completed

COMPLETED

Map No. _____ Sec. 26 Twp. 20 R. 12WWell No. 5 Bryant "C"Alpine Oil

Company

Contractor

NW SW SW

SECTION PLAT



_____ Ft. from N. Line

990 Ft. from S. Line

_____ Ft. from E. Line

330 Ft. from W. LineBarton County

Location _____

Rig up _____

Drilling and Remarks:

R U R

RECORD

Cased _____ in., _____ ft.

Sand _____

Gas _____

Oil _____

Total Depth _____

PRODUCTION

1st 24 hrs. Nat. _____

1st 24 hrs. after shot _____

Gas _____ Cu. Ft.

Dry Hole _____

Abandoned _____

Date

J. E. TYRAAPR 5 1950 19

Scout

Kansas

Map No. _____ Sec. 26 Twp. 20 R. 12WWell No. 5 Bryant "C"Alpine Oil Company

Contractor

NW SW SW

E. 1827
SECTION PLAT

_____ Ft. from N. Line

990 Ft. from S. Line

_____ Ft. from E. Line

330 Ft. from W. Line

COMPLETE			
o			

Barton

Location _____

Rig up _____

Drilling and Remarks:

8" @ 258
 Lens 3142
 Arb 3376
 5" @ 3377
 97 BOPD

RECORD

Cased _____ in., _____ ft.

Sand _____

Gas _____

Oil _____

Total Depth 3410

PRODUCTION

1st 24 hrs. Nat. _____

1st 24 hrs. after shot _____

Gas _____ Cu. Ft.

Dry Hole _____

Abandoned _____

 Date MAY 10 1950
MAY 10 1950

19

J. E. TYRA
Scout