


Section 32 Township 31 Range 6E

Well No. 3 Mercer

Company Alf Landon

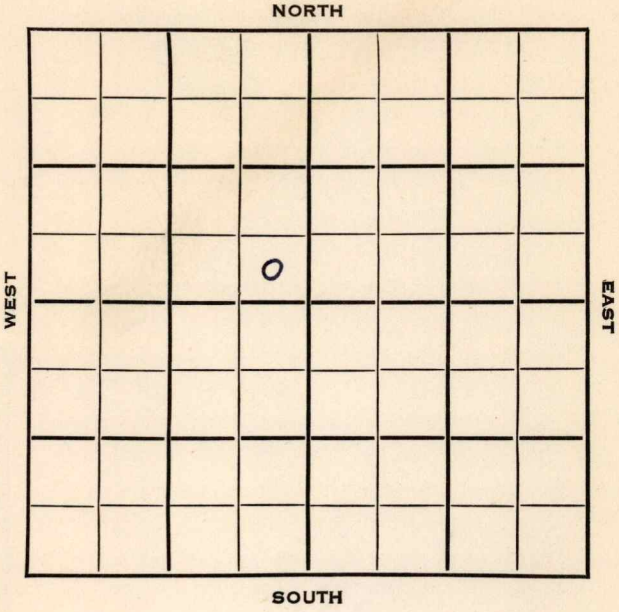

Cowley

KANSAS

|      |      |     |
|------|------|-----|
| SEC. | TWP. | R.  |
| 32   | 31   | 6 E |

WELL NO.

# 3 Mercer

FARM

COMPANY

Alf Landon

CONTRACTOR

Sunflower Drlg.

E. Burden Pool


Ft. from N. Line

330 Ft. from S. Line

330 Ft. from E. Line

Ft. from W. Line

SE SE NW

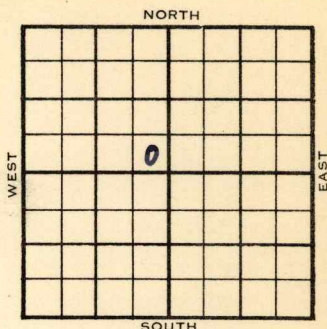

1953

ELEVATION

1363'

REPORT

11/4

Drilling

11/24

Spud 11-1-53

Oil Well

TD 2309'

8" @ 136'

Stal. 1835', Layton 2243'

TD 2309'

5" @ 2309'

16/2268-73, SP 2263, 36/2246-58

FU 750' oil, 750' wtr, 7 hrs.

Comp. 40 bopd 7 bw

COMPLETED



County Cowley State Kansas  
 Sec. 32 (Blk.) 31 (Sur.) 6 E Map No.   
 Operator Alf Landon  
 Well No. 3 Farm Mercer  
 Elev. 1363 Location SE SE NW

|          |  |  |  |  |  |  |  |  |  |
|----------|--|--|--|--|--|--|--|--|--|
| COMPLETE |  |  |  |  |  |  |  |  |  |
|          |  |  |  |  |  |  |  |  |  |
|          |  |  |  |  |  |  |  |  |  |
330 Ft. From S Line NW  
330 Ft. From E Line Quarter  
 1st. Report   
 Completion NOV 24 1953  
 Remarks E. Burden Pool  
Sunflower Drlg. - Contr.  
 Spudding Date 11-1-53

Drlg. Data Oil well TD 2309  
8" @ 136 Stal. 1835 Layton 2243  
TD 2309 5" @ 2309 16/ 2268-73  
SP 2263 36/ 2246-58 FU 750' oil  
750' wtr. 7 hr. Comp. 40 bopd 7 bw

J. G. McGEHEE